7-1-96
cloudy
>0° 7-1-96 HLS


24

S¼ cor SEC. 32-101-17
Cert. Filed 8-8-96
NO Information Found in Mower Co Records

5/17/32 USED IOWA RAILROAD TO LOCATE THE CORNERS. This cor. is 1906.2'E. of the NW cor of (IOWA cor) SEC. 7-100-17 AND 2142.4' WEST of NE cor of SEC. 7-100-17, PAGE-38

JHS CREW USEING IOWA Records Dug by HAND, UNCOVERED 2.5' IRON BENT. REMOVED BENT IRON, REPLACED WITH ⅝"x16" IRON with CAST IRON MON OVER, SET MON 40 BELOW ROAD SURFACE.

TO	NE cor SEC. 7-100-17	Fd ⅝"ø
FS	S¼ cor SEC. 32	Fd ⅞"ø
D	1906.2	

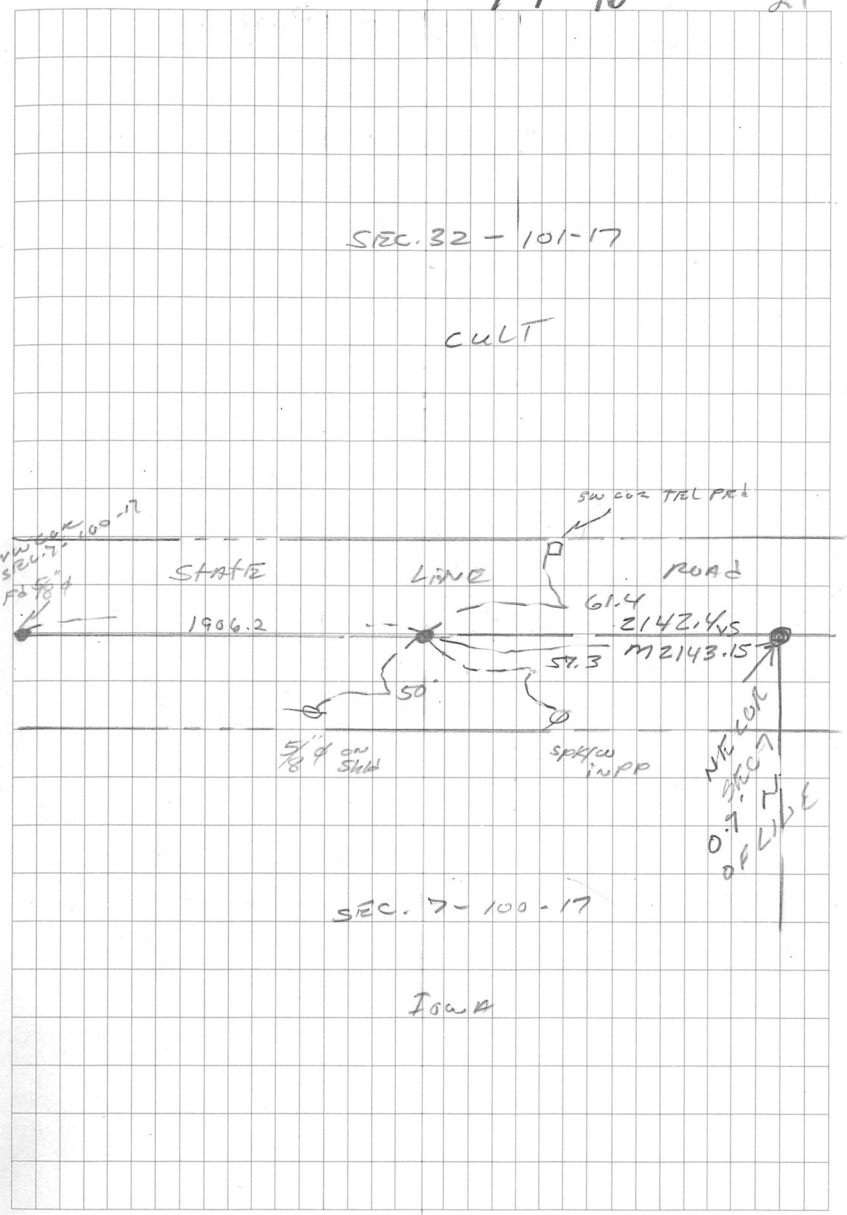

MEAS. TO SET SEC
& 1/4 SEC CORS ON
SO. LINE TWP 101-17

5746.55 E
7470.64 W + 2641.10
4843.86 W
2204.24 W
446.22 E
3105.38 E

