
SW cor SEC. 33-101-17
Cert Filed 8-8-96
No Information Found in
Mower Co. Records.

THS CREW dug with Mower Co.
Backhoe on E of State Line
Road. 4'X5' Hole 4'± deep
at a dist of 2640, From St cor
of Sec. 32, And No Evidence
of PLS Corner. SET COR
ON ST LINE BETWEEN
S1/4 COR SEC 32 & S1/4
COR SEC 33 & MIDPT

8-20-04 SAT AKP FD CIM TOP BROKEN OFF.

7-12-96
Cloudy
75°
HLS
JPA

37

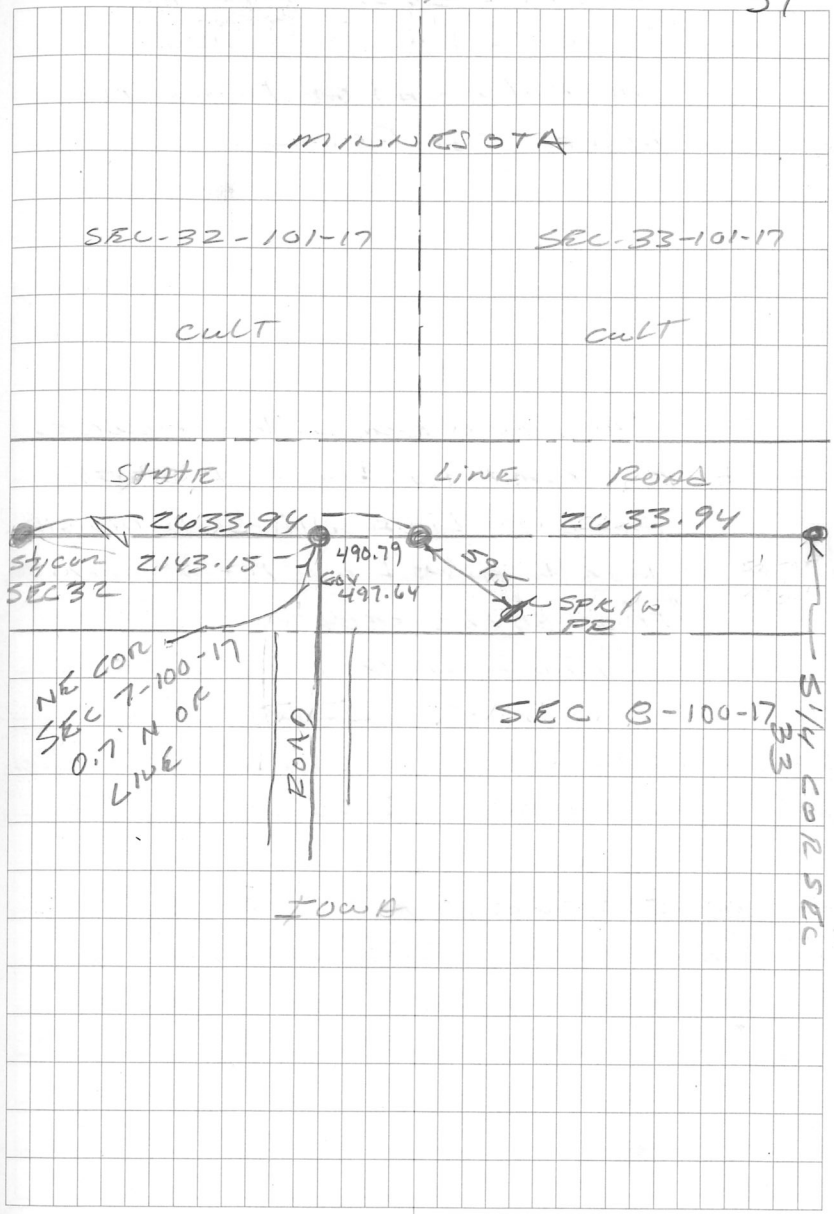

MEAS. TO SET SEC
& 1/4 SEC CORS ON
SO. LINE TWP 101-17

5746.55 E
7470.64 W + 2641.10
4843.86 W
2204.24 W
446.22 E
3105.38 E

