S/4 cor SEC 33-101-17


Cert. Filed 8-8-96

No Information Found in Mower County Records.

JHS crew dug with Mower County Backhoe, on ℄ of State Line Road & Twp Road North, Dug a 12'x6' by 4' deep to virgin soil and found no evidence of PLS corner. SET CIM IN LINE WITH ℄ TWP ROAD TO NORTH & ON ST LINE BETWEEN N'/4 COR SEC 9-100-17 & S'/4 COR SEC 32-101-17

7-2-96 HLS

CLEAR 80'

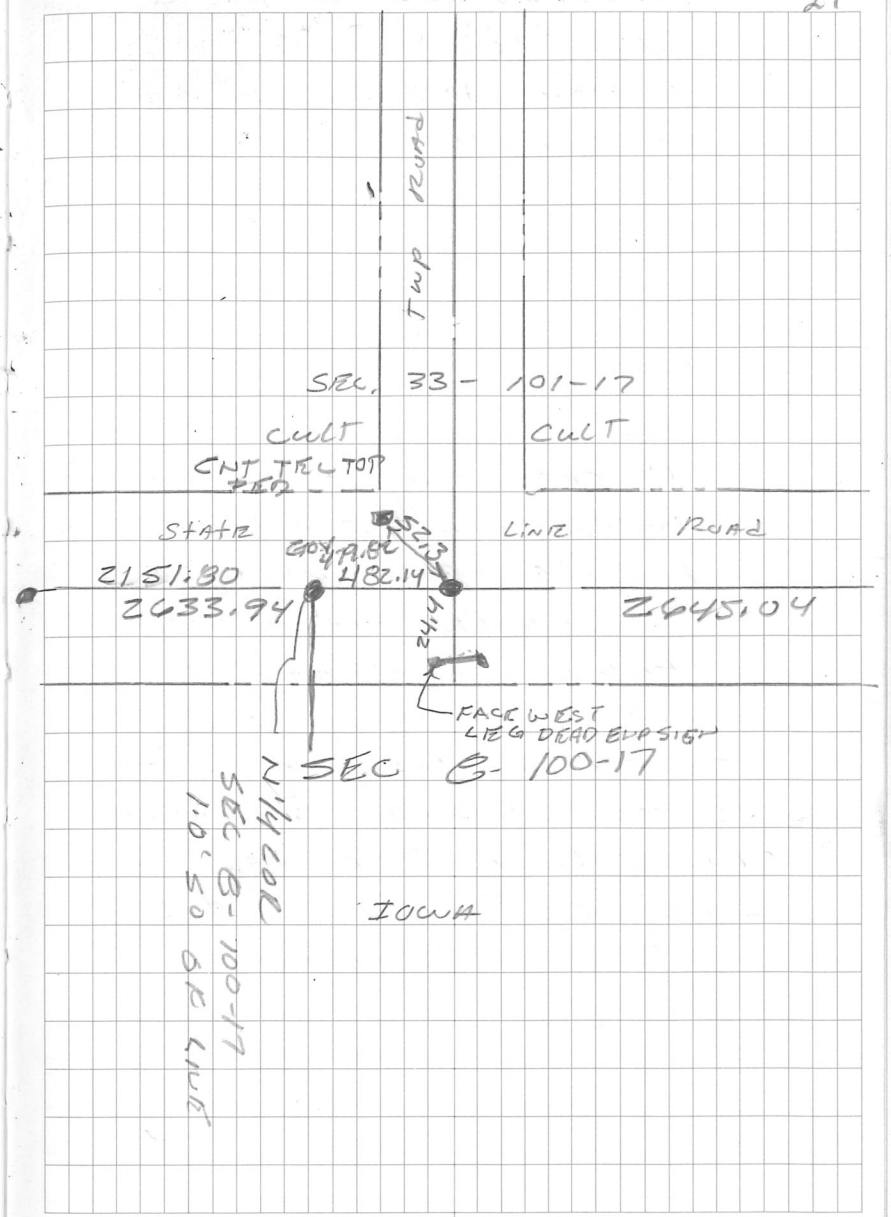

MEAS. TO SET SEC
& 1/4 SEC CORS ON
SO. LINE TWP 101-17

5746.55 E
7470.64 W + 2641.10
4843.86 W
2204.24 W
446.22 E
3105.38 E

