SW COR SEC. 34-101-17

Cert. Filed 8-8-96

NO INFORMATION FOUND IN MOWER CO. RECORDS

JHS CREW Dug with MOWER CO. BACKHOE ON ℄ of STATE ROAD IN LINE with FIELD DIVISION NORTH AND AT a DIST of 2640. FROM S¼ COR SEC. 33.

Dug a 4'/8' HOLE 4' DEEP UNCOVERED REMAINS of OLD 12" ± CULVERT IN AREA of PLS CORNER


But Found NO EVIDENCE of PLS CORNER.

SET ⊂ I. M. ON ST LINE BETWEEN S¼ COR SEC 33 & S¼ COR SEC 34 @ MIDPOINT.

7-12-96
Cloudy
75°

HLS
JDA

38

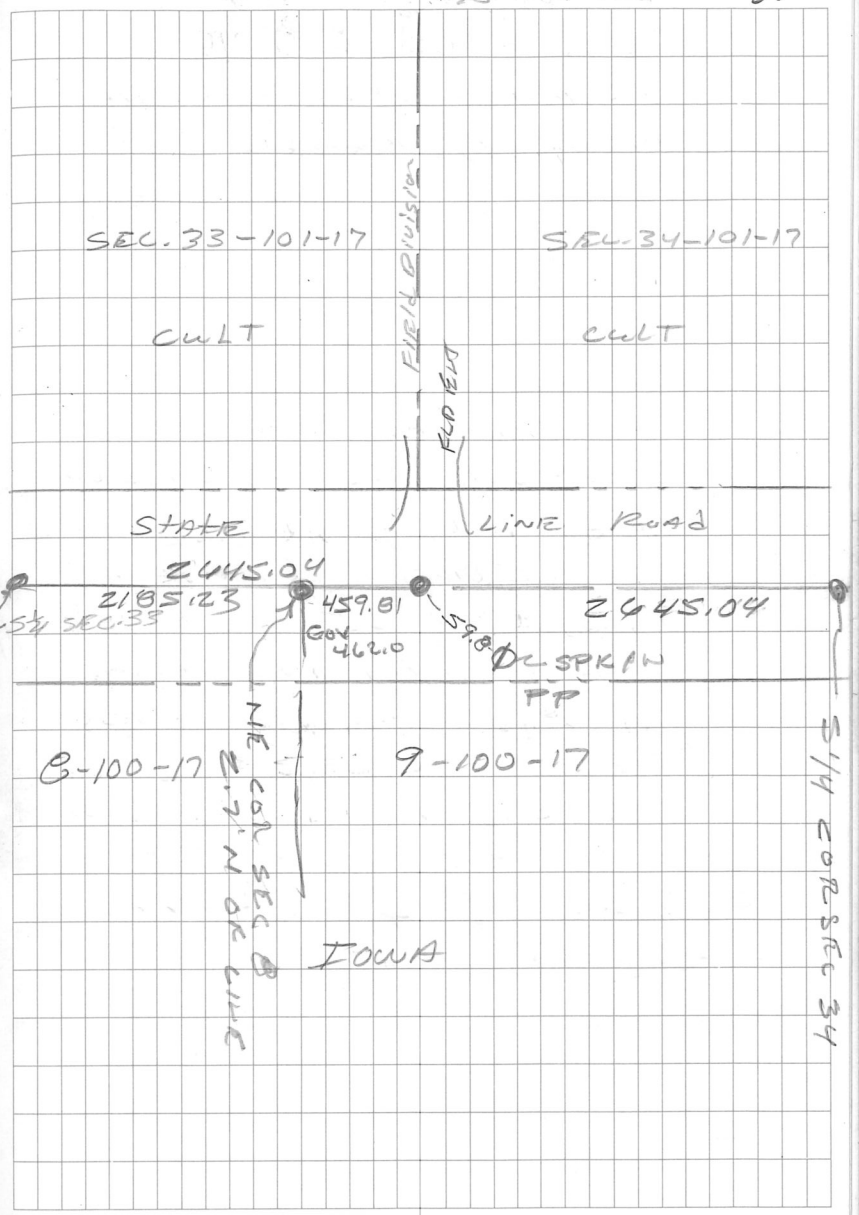

MEAS. TO SET SEC
& 1/4 SEC CORS ON
SO. LINE TWP 101-17

5746.55 E
7470.64 W + 2641.10
4843.86 W
2204.24 W
446.22 E
3105.38 E

