S¼ Cor SEC. 34-101-17

Cert. Filed 8-8-96


NO INFORMATION FOUND IN MOWER CO. RECORDS

JHS CREW dug with MOWER CO. BACKHOE, ON ℄ LINE of STATE LINE ROAD & ℄ of TWP ROAD NORTH, Dug a 6'X12' HOLE 4' DEEP to VIRGIN SOIL & FOUND NO EVIDENCE of PLS CORNER.

SET CIM IN LINE WITH ℄ TWP ROAD TO NORTH ON ST LINE BETWEEN N¼ COR SEC 9-100-17 & S¼ COR SEC 35-101-17

7-2-96 CLEAR 80° HLS

28

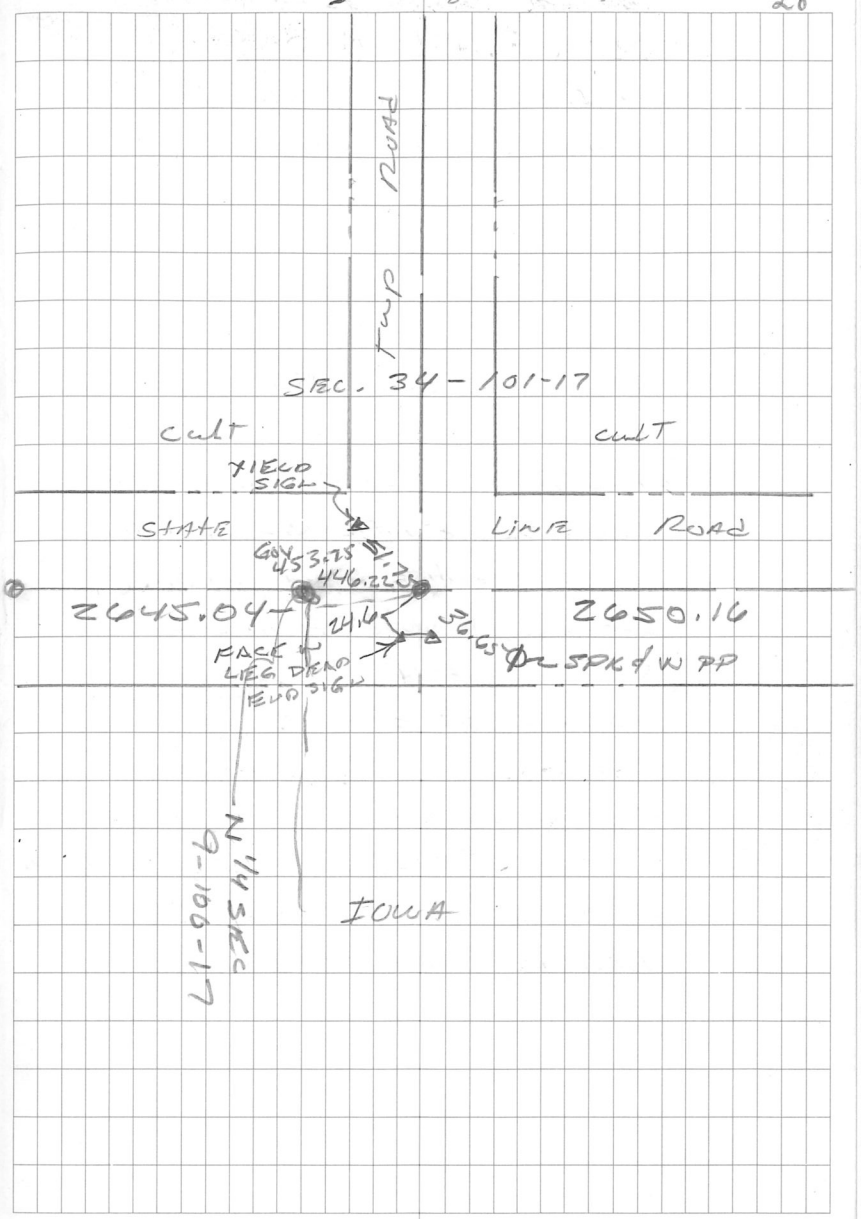

MEAS. TO SET SEC
& 1/4 SEC CORS ON
SO. LINE TWP 101-17

5746.55 E
7470.64 W + 2641.10
4843.86 W
2204.24 W
446.22 E
3105.38 E

