
SW cor SEC. 35-101-17
Cert. Filed 8-8-96
No Information Found in
Mower Co. Records

JHS CREW dug with Mower
Co. MOWER ON ℄ of STATE LINE
ROAD & IN LINE with LINE FENCE
North at dist, of 2640± from
SW cor of SEC. 35. DUG 3'X15'
HOLE 1.5' DEEP AND was in
to VIRGIN Soil. CORNER RESTORED
by ROAD GRADER.
SET C.I.M. @ MIDPOINT
OF A ST. LINE BETWEEN
S1/4 COR SEC 34 & S1/4 COR
SEC 35.

7-12-96
CLOUDY
75°
HLS
JPP

39

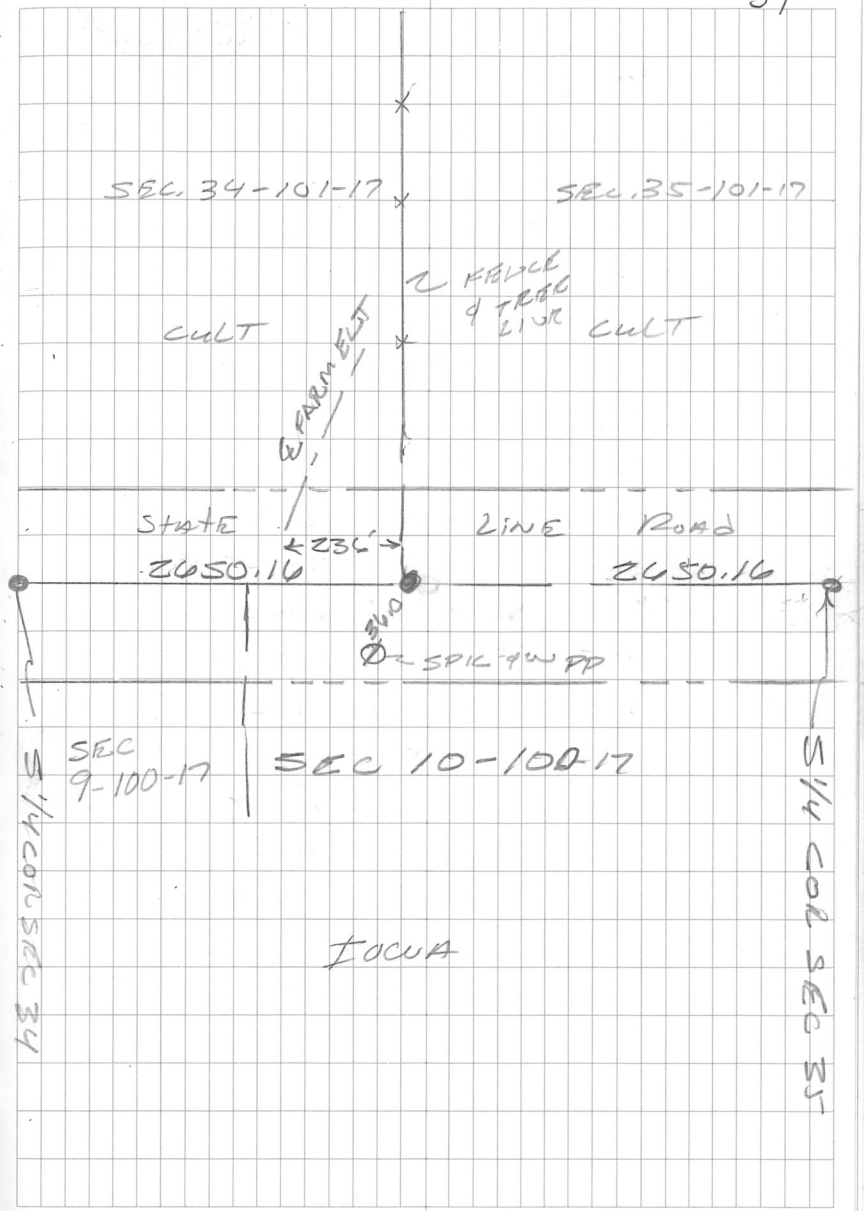

MEAS. TO SET SEC
& 1/4 SEC CORS ON
SO. LINE TWP 101-17

5746.55 E
7470.64 W + 2641.10
4843.86 W
2204.24 W
446.22 E
3105.38 E

