7-2-96 HLS

29

Sec cor SEC. 35-101-17


Cert. Filed 8-8-96

No Information Found in Mower County Records.

JHS CREW dug with Mower Co. Backhoe, dug on ℄ of State Line Road ℄ Line Fence North.

Uncovered 2 Stones - 2.0' Deep 2'x1' Pointed Stone with Smaller Pointed Stone on South Side, Stones Fit Line Fence North. Left Mons As Found Placed a 5/8"ϕ Between Stones Cap No. 13807.

Set 5/8"x16" Iron with Castiron Mon over Stones Found, .40 Below Road Surface.

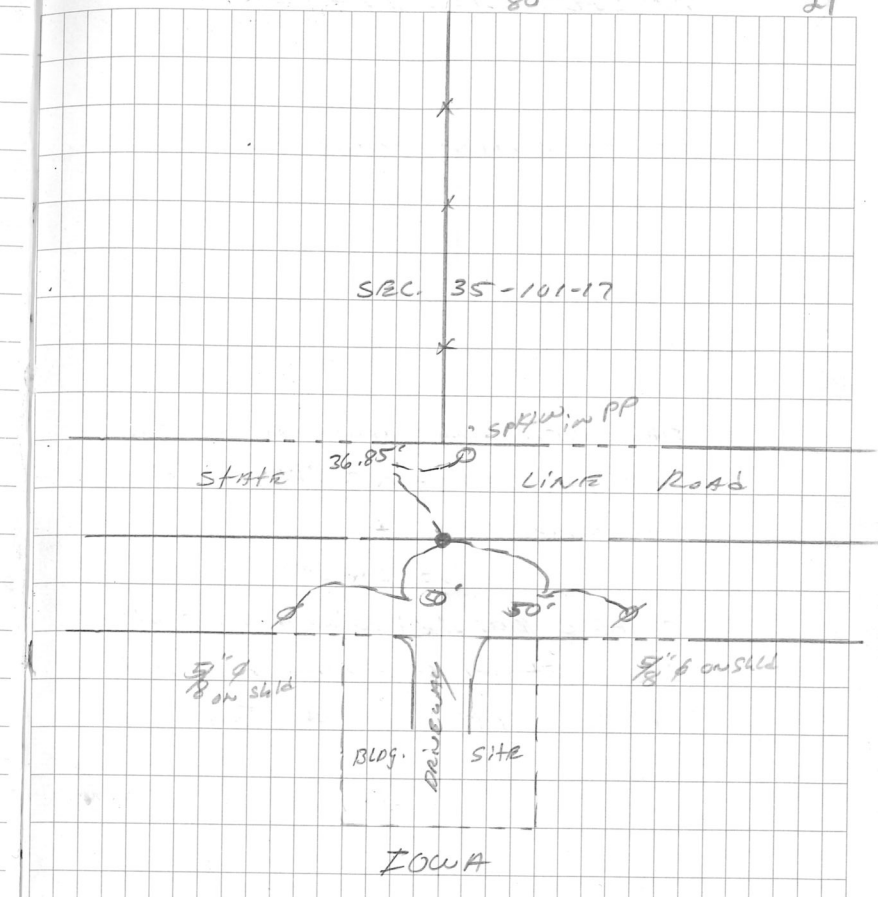

MEAS. TO SET SEC
& 1/4 SEC CORS ON
SO. LINE TWP 101-17

5746.55 E
7470.64 W + 2641.10
4843.86 W
2204.24 W
446.22 E
3105.38 E

