
5-13-91 DRR/RMK 13.

SW Cor Sec 36-101-17
Cert. Filed 5-16-91 by JHS
Dug with Co. backhoe on Rds for bitum. overlay project # SAP 56-619-14

Dug a 6'x 8' x 3' deep hole and uncovered a harrison CIM 0.5' deep cont. digging and uncovered a 8"x 16" long pointed stone over a nest of 4 small stones 3' deep in virgin soil placed 5/8 ϕ iron on east side of stone set CIM over stone on surface.

10-19-04 HLS-MHS
CORNER DESTROYED @ TIME of OVERLAY.
RESET COR. USING TIES.
1 SET 5/8" w. 1m CAST IRON MON @ RD. SURFACE.

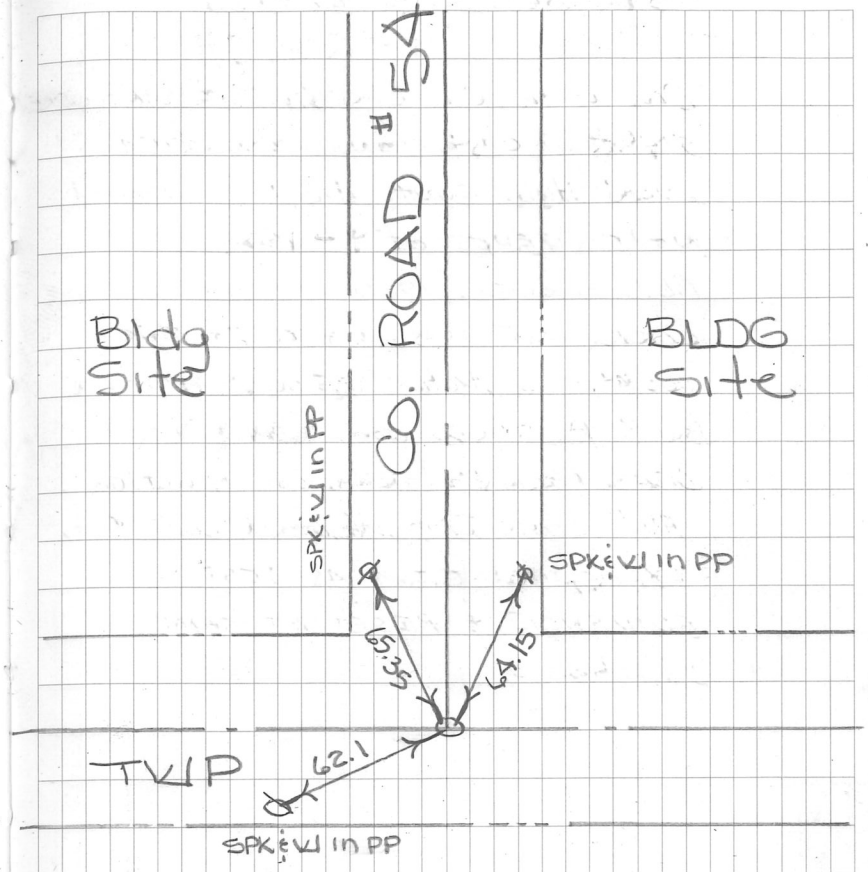

STATE OF IOWA
CULT