10-20-04 HLS
CLOUDY MHS
55°

2

S¼ COR SEC. 36-101-17


NO INFORMATION FOUND IN MONONA CO. CORNER RECORDS

JHS CREW DUG WITH BOBCAT BACKHOE. ON 4 E-W TWP RD AND IN LINE WITH LINE FENCE NORTH.

UNCOVERED OLD ROAD BED DOWN 3'±, CONTINUED DIGGING DOWN TO VIRGIN SOIL AND FOUND NO EVIDENCE OF PLS CORNER.

SET CORNER ON STRAIGHT BETWEEN SEC COR & SW COR. AT SPLIT.

SET 5/8" X 16" IRON WITH CAST IRON MON. 60± BELOW RD SURFACE.

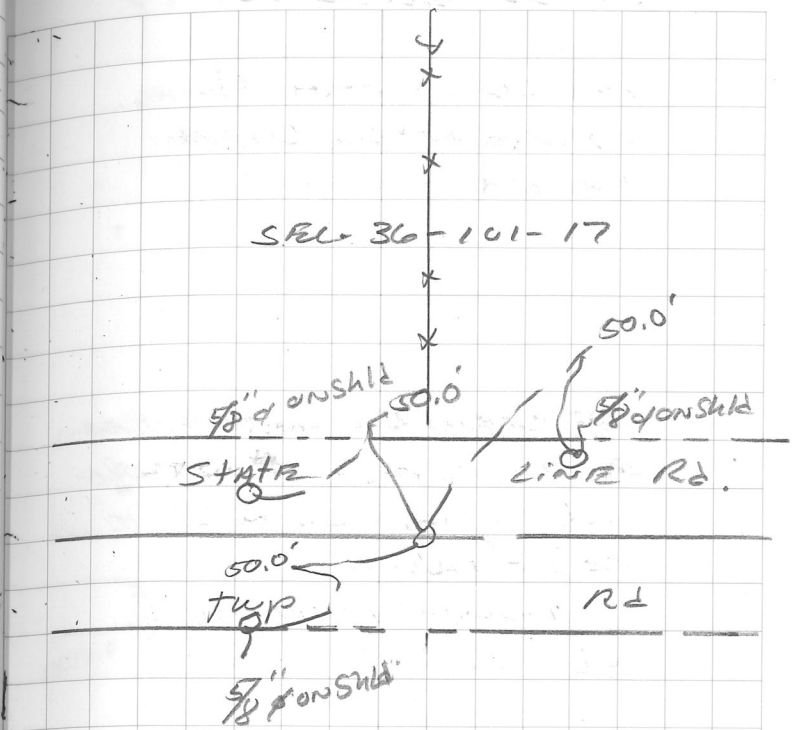

IOWA