7-31-02
Cloudy
90+
HLS
GKB

SW COR SEC. 31 - 101 - 16

MOWER CO. RECORDS STATE
2" CONC. MON INP —
STEEL PIPE BELOW.


GOV. 6.73 CHAINS EAST of
SEC 11 - 100 - 17 (IOWA)

JHS CREW DUG with MOWER CO.
BACKHOE ON ℄ ℄ of E-W TWP RD
AND TWP RD North.

UNCOVERED CONC. MON
with ½" IRON in CNT. ALSO
WOOD HUB ON EAST SIDE of
MON.

PLACED ⅝" x 16" IRON
CAPPED 13807 ON South SIDE.

SET ⅝" x 16" IRON with
CAST IRON MON OUTER
CONC MON FOUND 60± BELOW
RD SURFACE.

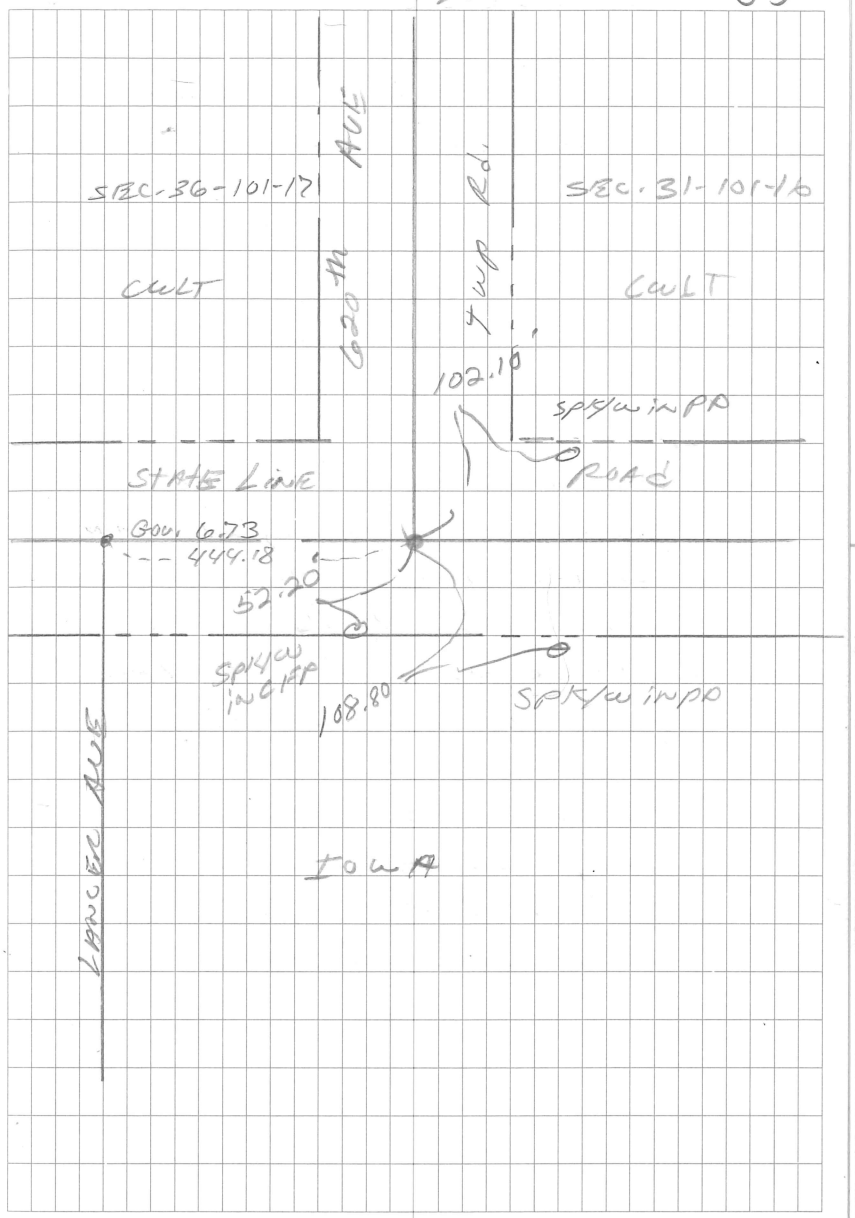

ADAMS Twp - South Line

SEC.'S 31 & 32

BS	① POL		⊙ spk/w
	④ SW cor SEC. 31		Fd ctm
D	3143.73		
FS	⑤	Iowa cor	Fd spk/w
∠	00°00'00"	3585.73	
FS	③ PC Line South Iowa		
∠	00°00'00"	941.48	
FS	② S¼ cor SEC. 31		⊙ spk/w
∠	00°00'00"	490.14	451.34
FS	⑥	Iowa cor	Fd ½" ø
∠	179°54'43"	1717.81	
FS	SE ⑦ cor SEC. 31		Fd ctm
∠	180°00'00"	2160.92	
FS	⑧ S¼ cor SEC. 32 on C&R Rd.		⊙ spk/w
∠	180°00'00"	4810.27	
FS	⑨ SE cor SEC. 32		Fd ctm
∠	180°01'42"	7463.98	

NH

8-14-02 Cloudy 75° HLS

59

