
$N\frac{1}{4}$ COR SEC 1-101-18
Cert. Filed 5-21-93 by JHS

1993 JHS INC CREW FOUND 1"x2" IRON BAR AND SET CIM

5-21-93 FKS
PT. CLOUDY 70° TJF 22°

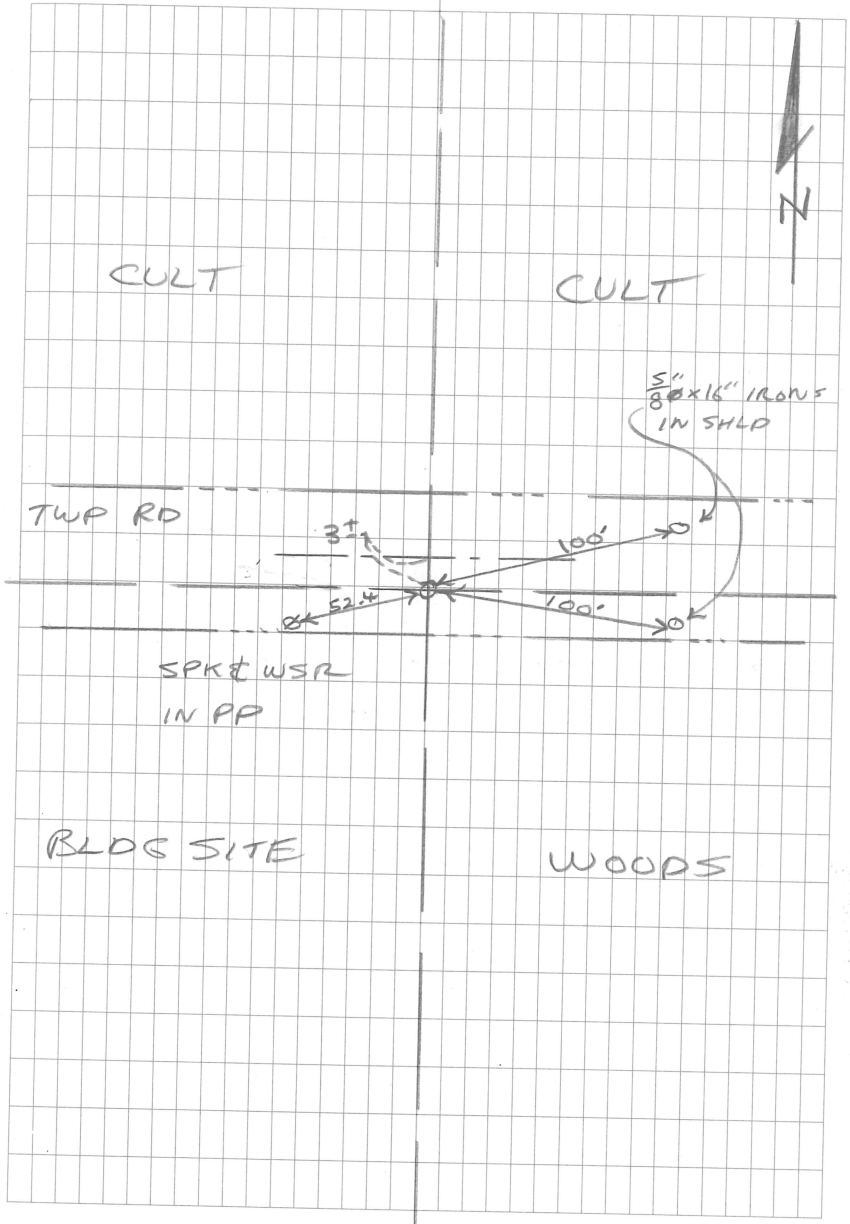

N 1/4 Cor Sec 1-101-18

F 2 1/2" x 3/4" iron bar
3' so. ℄ E-W roads
in line with fe. N.