S¼ cor SEC. 35 - T102N - R18W
Cert. Filed 8-16-96 by JHS


NO RECORDS FOUND

9-13-94 JHS CREW dug with county BACKHOE ON CENTER LINE of TWP ROAD & IN LINE with LINE FENCE South, FOUND NO EVIDENCE of CORNER.

SET CORNER ON STRAIGHT LINE BETWEEN S¼ CORNER of SEC. 34-102-18 AND SE COR of SEC. 35-102-18 IN CENTER LINE of ROAD & IN LINE with FENCE South. & IN LINE WITH FENCE LINE APPROX 1/4 MILE TO NORTH

SET ⅝"X16" IRON with CAST IRON MON ABOUT 4" BELOW ROAD SURFACE

9-13-94 HLS
Cloudy
80°

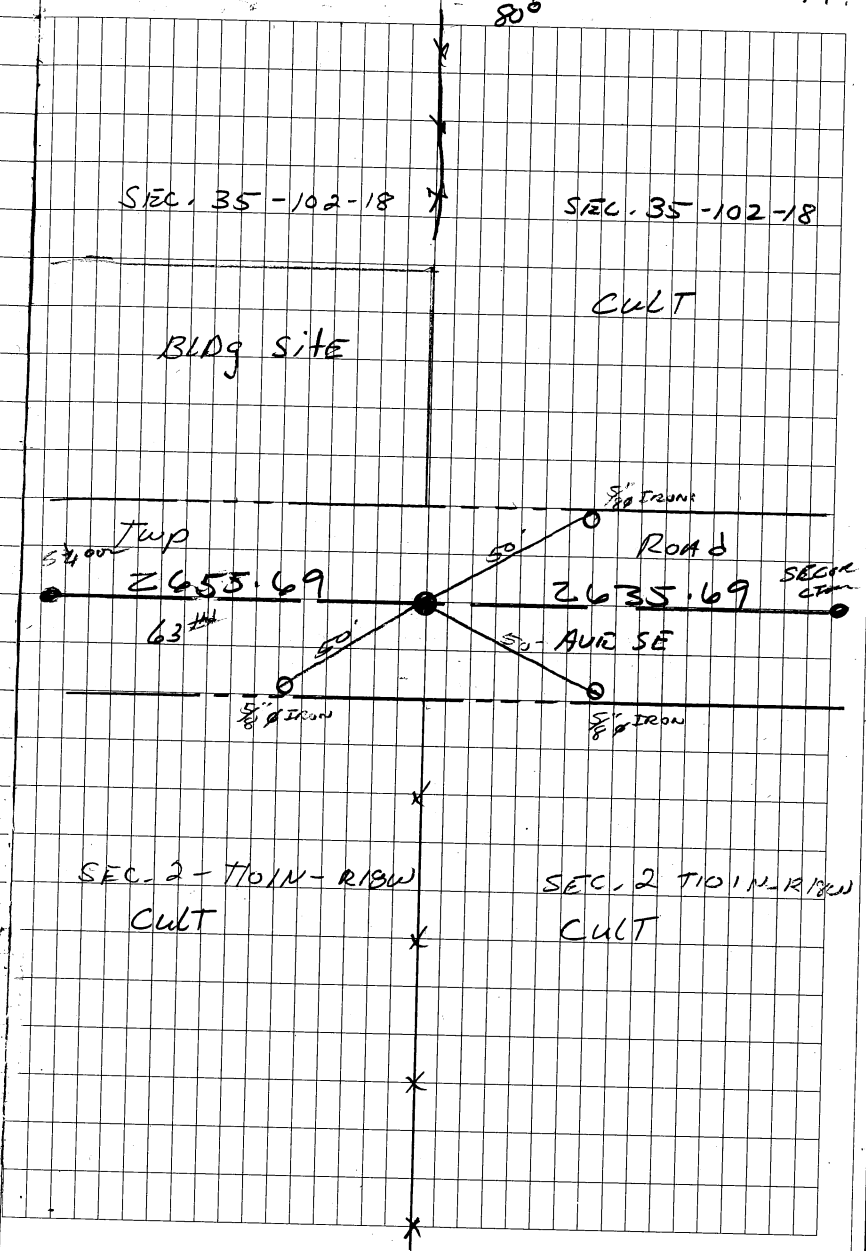

9-17-24
Cloudy
75°


HLS
JTS

(21)

SEC. 35 & 34 — 102-18

SE cor - S¼ cor & SW cor SEC. 35

S¼ cor SEC. 34

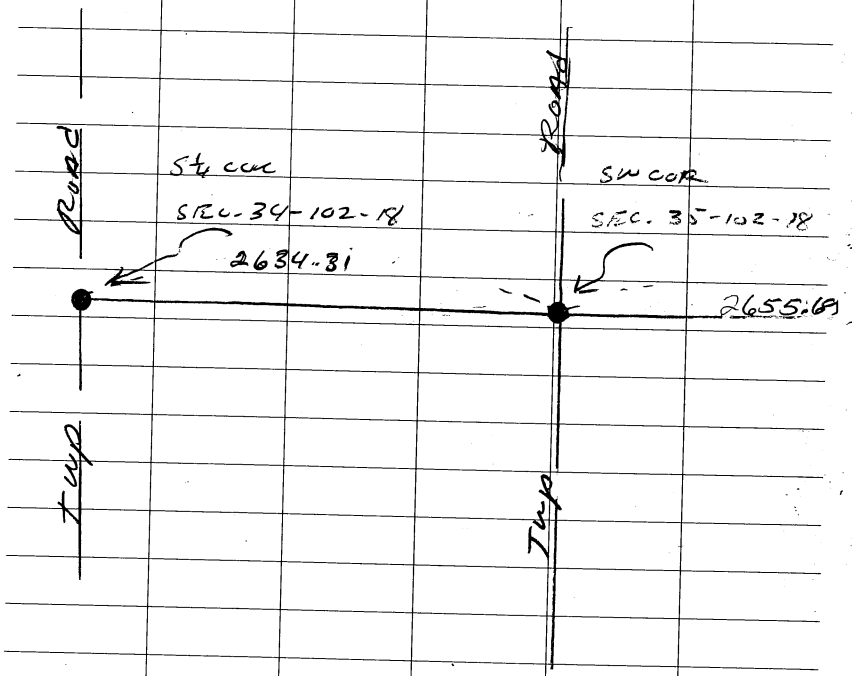

5311.38 ÷ 2 = 2655.69

