9-17-24
Cloudy
75°


HLS
JTS

(21)

SEC. 35 & 34 — 102-18

SE cor - S¼ cor & SW cor SEC. 35

S¼ cor SEC. 34

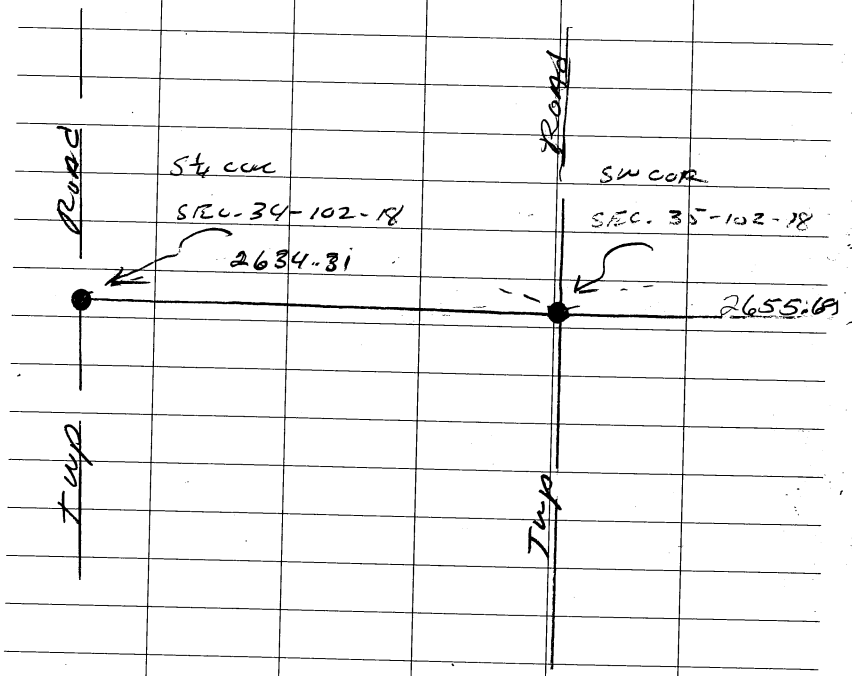

5311.38 ÷ 2 = 2655.69

