
SW Cor SEC. 35 - T102N - R18W
Cert. Filed 7-25-96 by JHS

No Records Found

9-13-94 JHS crew dug with County Backhoe in INTERsection of Twp Roads East - West and North - South. Dug hole 6'x8'x 4.5' deep to Virgin Soil, Found no Evidence of Corner.

SET CORNER ON STRAIGHT LINE between S¼ of SEC. 34 AND SE cor of SEC. 35 AND IN CENTER LINE of Twp Rd. N-S AND E & W
SET 5/8" X 16" IRON with CASTIRON MON. 4" BELOW ROAD SURFACE

9-13-94
Cloudy
80°

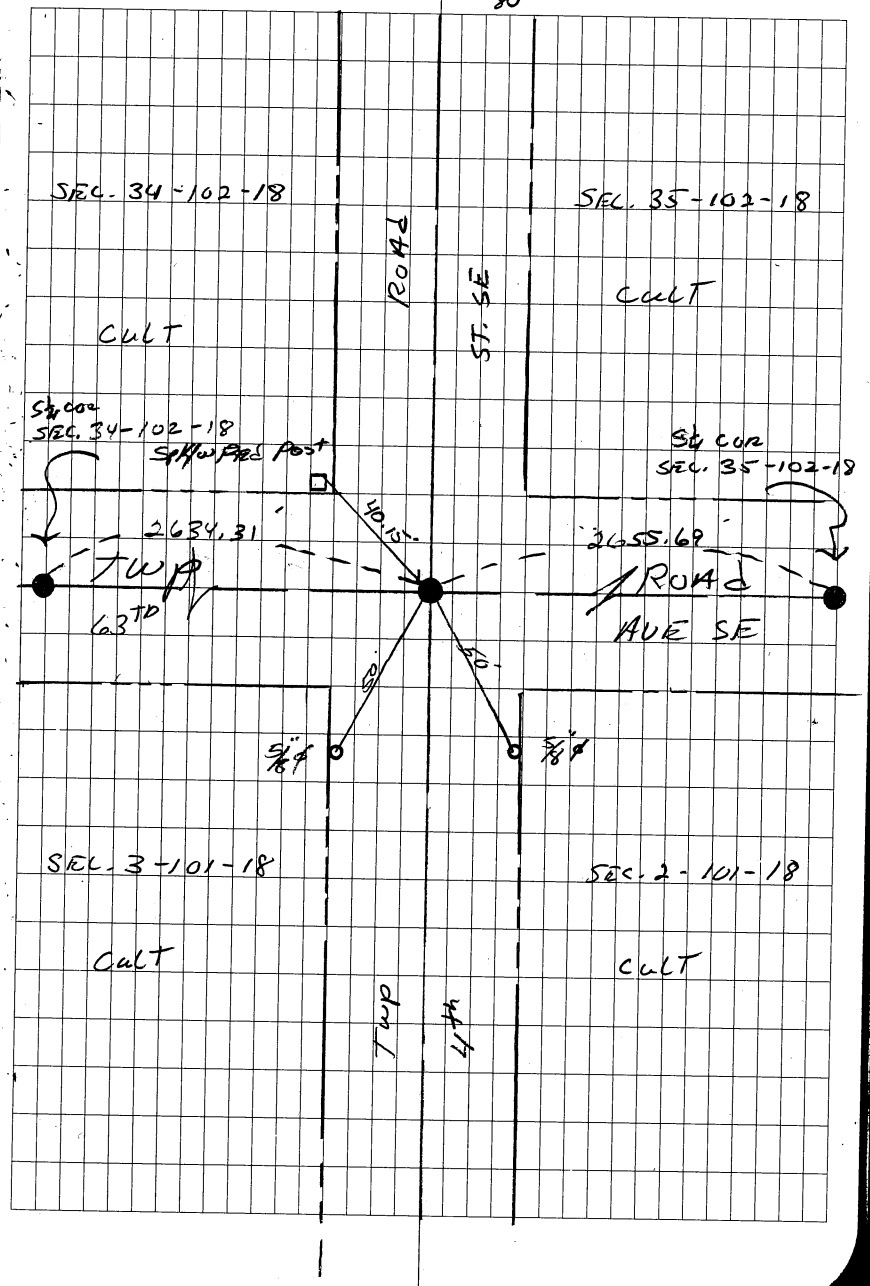

9-17-24
Cloudy
75°


HLS
JTS

(21)

SEC. 35 & 34 — 102-18

SE cor - S¼ cor & SW cor SEC. 35

S¼ cor SEC. 34

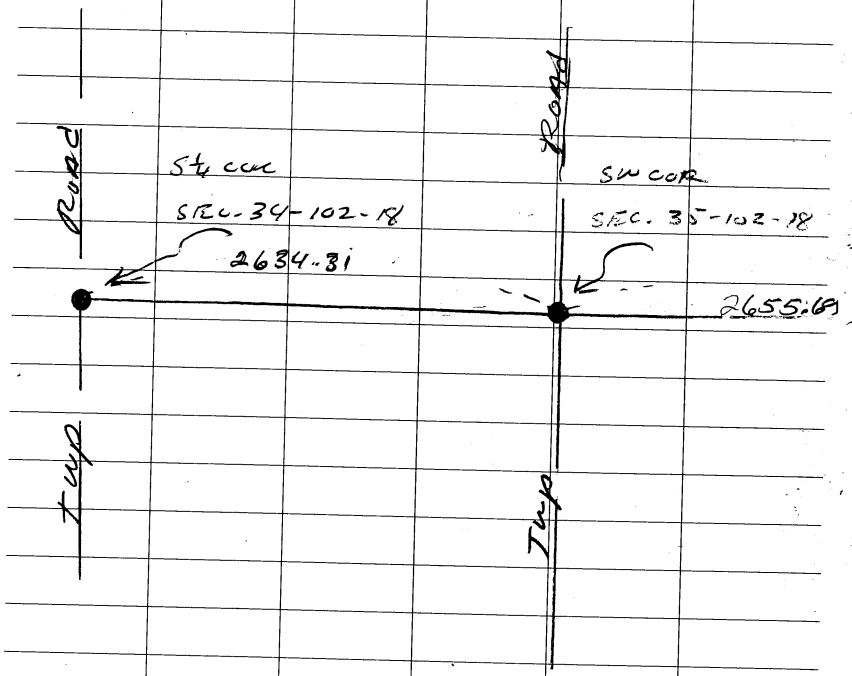

5311.38 ÷ 2 = 2655.69

