

4-17-91 DRR/RMK 1

N1/4 Cor Sec 15-101-18
Cert. Filed 5-23-91 by JHS

Dug with Co. backhoe for 1991 grading Project SAP # 50-605-10
Dug for ℄ PI
Uncovered a 1/2"ϕ iron 1' below road surface continued digging & uncovered a 1/2"ϕ iron cast in a 6" dia conc. monument 3' deep in virgin soil, Placed capped 5/8"ϕ iron. measured 13.0 ft. south and dug a 6'x6'x5' deep hole and uncovered a 3/4" dia. pipe capped RJO 11009 cont digging and found no further evidence of corner Set CIM at location of pipe found.

5-28-03 UNCOVERED CIM PULLED NEW TIE TO SPK/W IN PP 62.80'

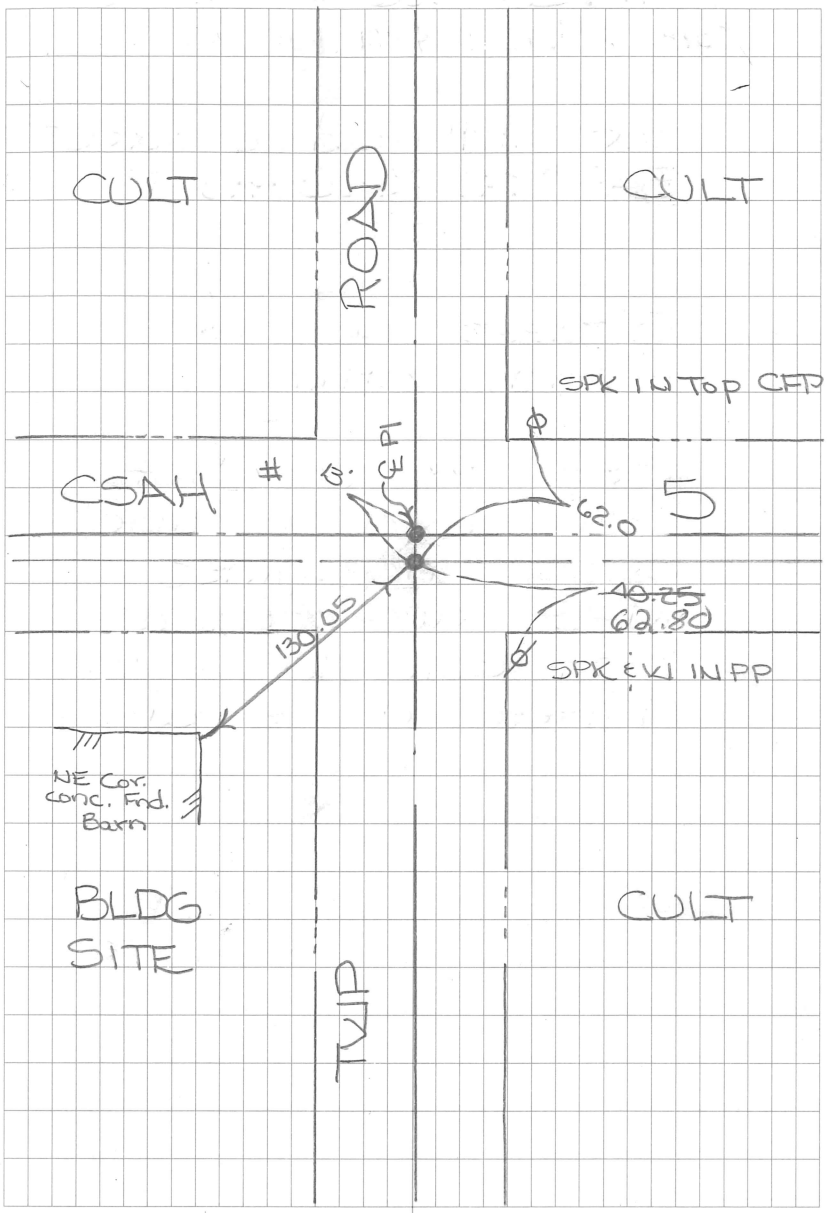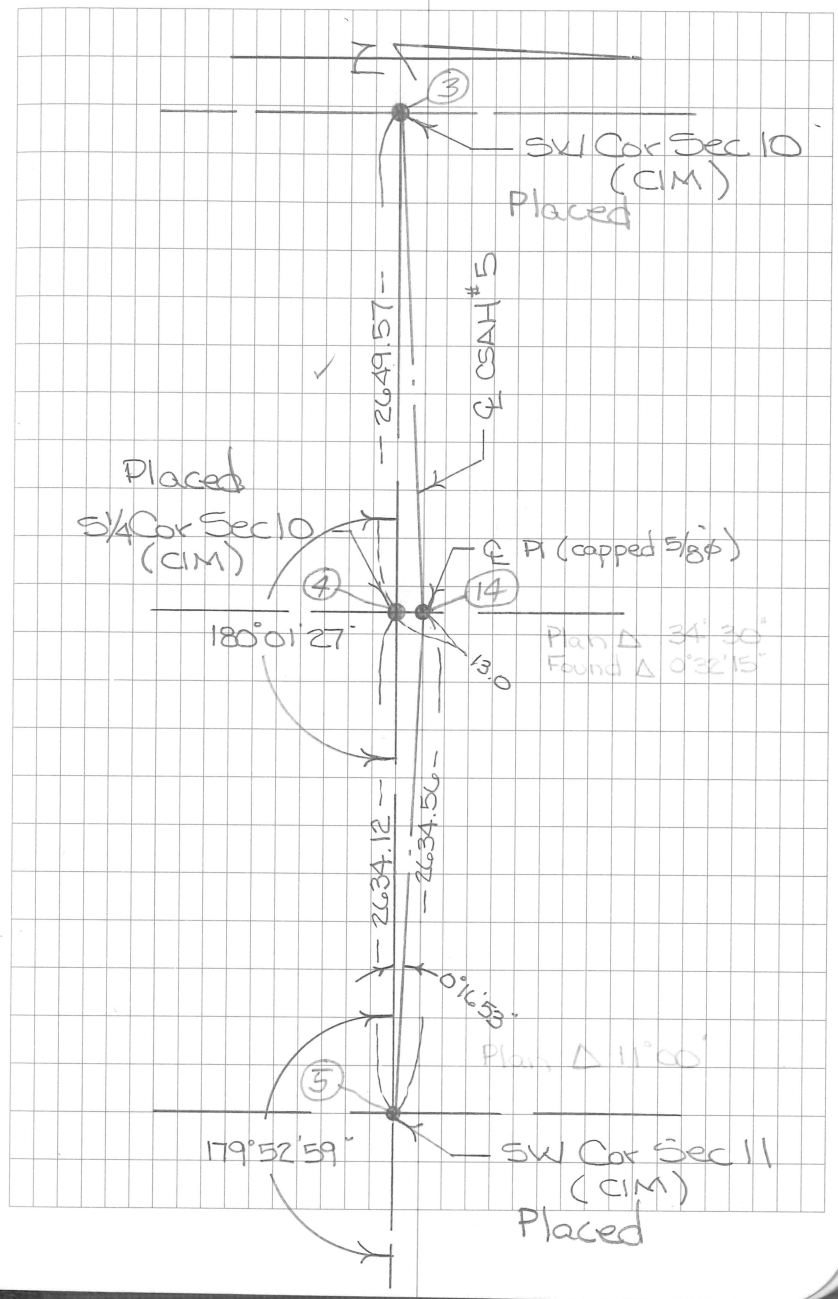


3
SW Cor Sec 10
(CIM)
Placed
2649.57
2 CSAH #5
Placed
S1/4 Cor Sec 10
(CIM)
PI (capped 5/8ϕ)
4
14
180°01'27"
Plan Δ 34° 30'
Found Δ 0°32'15"
13.0
2634.12
2634.50
0°16'59"
Plan Δ 11°00'
3
179°52'59"
SW Cor Sec 11
(CIM)
Placed

CSAH # 5
Proposed R/W Plat #1
TRD 52 - JOB 5

℄ @ SE Cor Sec 11

℄ 218 17.0' W ∠ W-N 90°36'15

℄ RR 394.87

S 1/4 Cor 2644.08
0°00'
SW Cor 5287.97



℄ RR W-N ∠ 85°47'10"



℄ @ SW Cor Sec 11
BK ST S 1/4 Cor Sec 11

S 1/4 Cor ∠ 179°53'01" 52'57"
Sec 10 D 2634.12
℄ PI ∠ 180°09'52" 2634.56



5-21-91 DRR/HLS 10.
PC

℄ @ S 1/4 Cor Sec 10
BK ST SW Cor Sec 11

SW Cor Sec 10
∠ 180°01'27" 28"
D 2649.57



℄ @ SW Cor Sec 10
BK ST S 1/4 Cor Sec 10

S 1/4 Cor Sec 9
∠ 180°23'12" 09"
D 2658.52



℄ @ S 1/4 Cor Sec 9
BK ST SW Cor Sec 10

E. End. bridge D 1225.12

W. End bridge D 1412.85