SW Cor Sec 11-101-18

Cert. Filed 5-9-91 by JHS

7-27-87


JHS Crew dog with backhoe on ℄ and uncovered a 6" dia Conc. monument w/ 3/4" ϕ iron cast in center 3.5' below road surface, Placed CIM over conc. mon. on road surface.


4-18-91

JHS Crew uncovered CIM 0.7 below road surface and took new ties

5-28-03 (SAT CSM) UNCOVERED CIM PULLED NEW TIE TO PP

4-18-91 HLS/RMK 7

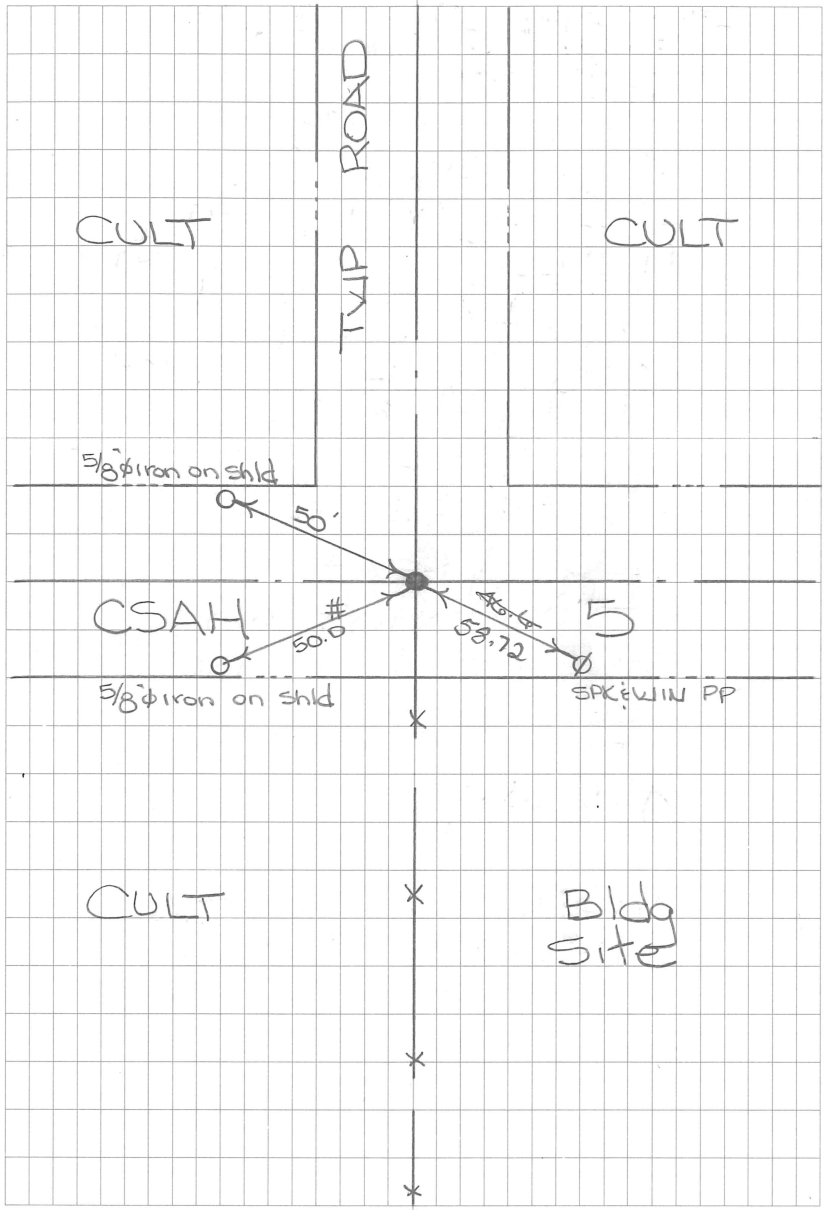

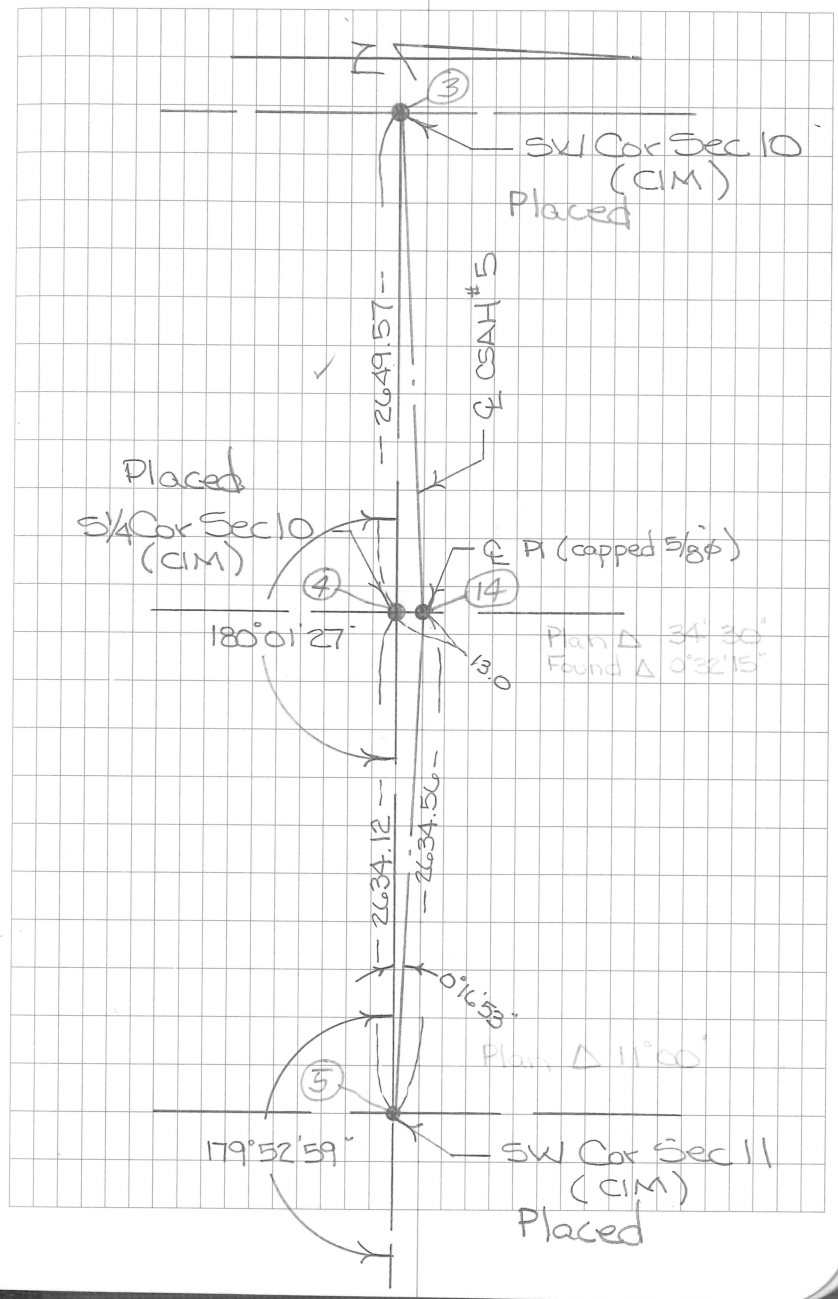
3
SW Cor Sec 10
(CIM)
Placed
2649.57
2 CSAH #5
Placed
S1/4 Cor Sec 10
(CIM)
PI (capped 5/8ϕ)
4
14
180°01'27"
Plan Δ 34° 30'
Found Δ 0°32'15"
13.0
2634.12
2634.50
0°16'59"
Plan Δ 11°00'
3
179°52'59"
SW Cor Sec 11
(CIM)
Placed

CSAH # 5
Proposed R/W Plat #1
TRD 52 - JOB 5

℄ @ SE Cor Sec 11

℄ 218 17.0' W ∠ W-N 90°36'15

℄ RR 394.87

S 1/4 Cor 2644.08
0°00'
SW Cor 5287.97



℄ RR W-N ∠ 85°47'10"



℄ @ SW Cor Sec 11
BK ST S 1/4 Cor Sec 11

S 1/4 Cor ∠ 179°53'01" 52'57"
Sec 10 D 2634.12
℄ PI ∠ 180°09'52" 2634.56



5-21-91 DRR/HLS 10.
PC

℄ @ S 1/4 Cor Sec 10
BK ST SW Cor Sec 11

SW Cor Sec 10
∠ 180°01'27" 28"
D 2649.57



℄ @ SW Cor Sec 10
BK ST S 1/4 Cor Sec 10

S 1/4 Cor Sec 9
∠ 180°23'12" 09"
D 2658.52



℄ @ S 1/4 Cor Sec 9
BK ST SW Cor Sec 10

E. End. bridge D 1225.12

W. End bridge D 1412.85