

N1/4 Cor Sec 16-101-18
Cert. Filed 5-9-91 by JHS
Dug with Co. backhoe for 1991 Grading Project
SAP # 50-605-10J
Uncovered Harrison CIM 1.5' below road surface assumed set by MN DOT tied off CIM removed and uncovered a 1" ø iron and wood stake 3' deep in virgin soil, reset CIM as found.

7-28-92 Reset CIM new ties

SPK & WI IN Guy Pole NE 59.3
SPK & WI IN PP SE 62.65

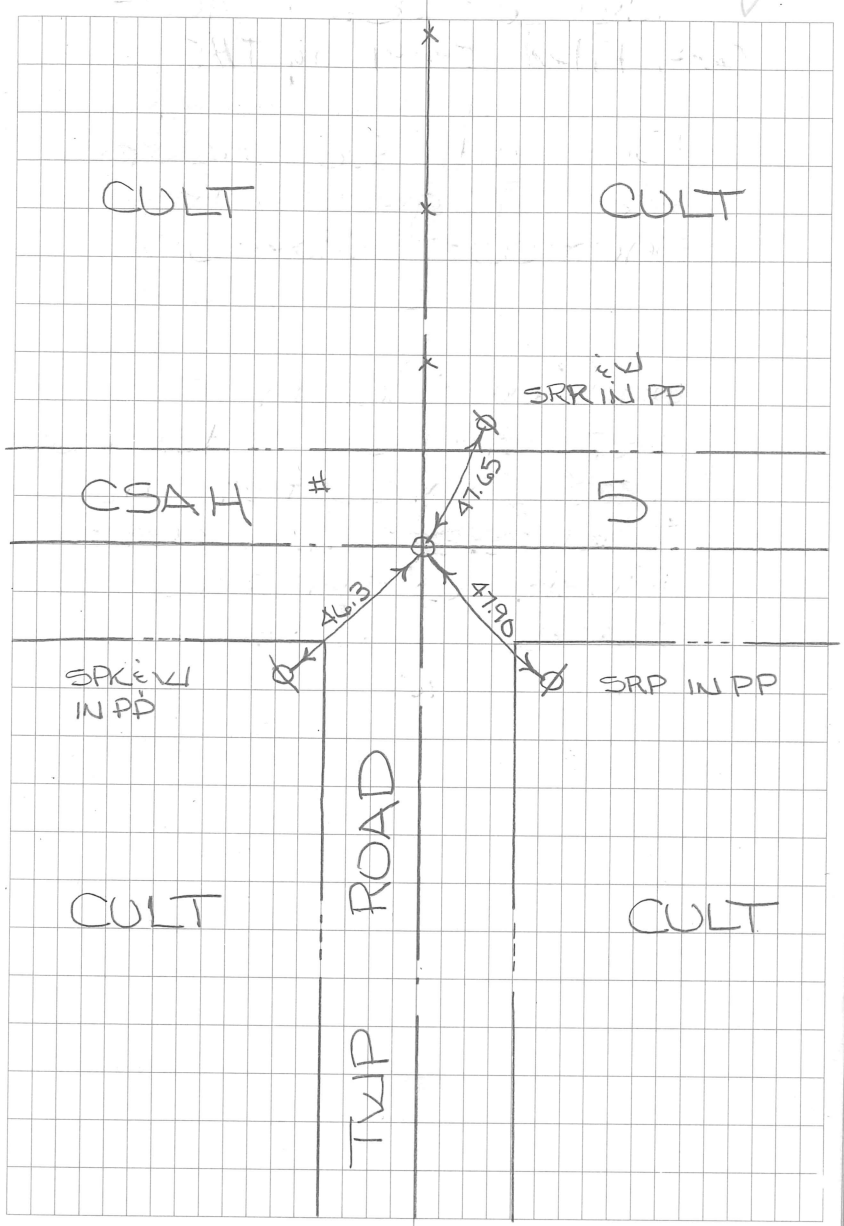

POL SE1/4 Sec 9
D 1173.16

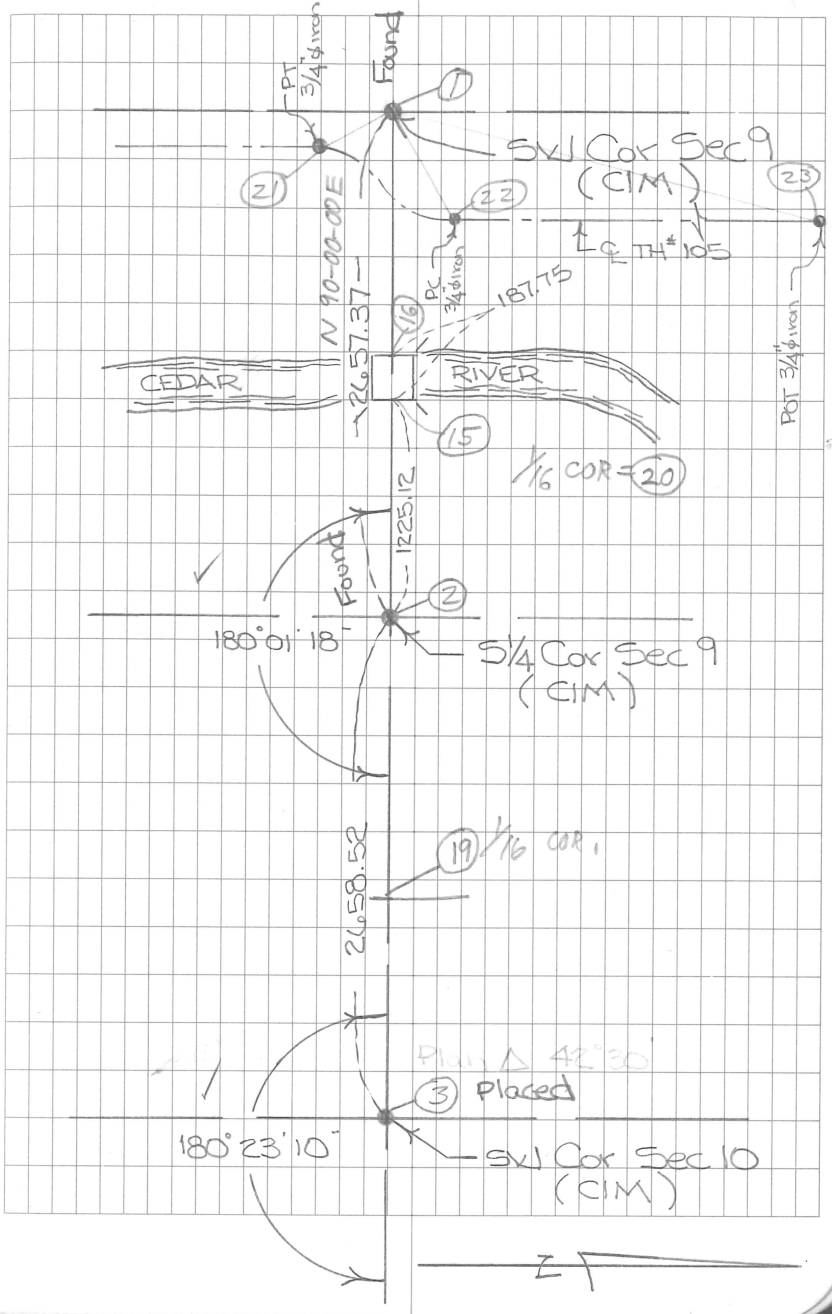

CSAH # 5
Proposed R/W Plat #1
TRD 52 - JOB 5

℄ @ SE Cor Sec 11

℄ 218 17.0' W ∠ W-N 90°36'15

℄ RR 394.87

S 1/4 Cor 2644.08
0°00'
SW Cor 5287.97



℄ RR W-N ∠ 85°47'10"



℄ @ SW Cor Sec 11
BK ST S 1/4 Cor Sec 11

S 1/4 Cor ∠ 179°53'01" 52'57"
Sec 10 D 2634.12
℄ PI ∠ 180°09'52" 2634.56



5-21-91 DRR/HLS 10.
PC

℄ @ S 1/4 Cor Sec 10
BK ST SW Cor Sec 11

SW Cor Sec 10
∠ 180°01'27" 28"
D 2649.57



℄ @ SW Cor Sec 10
BK ST S 1/4 Cor Sec 10

S 1/4 Cor Sec 9
∠ 180°23'12" 09"
D 2658.52



℄ @ S 1/4 Cor Sec 9
BK ST SW Cor Sec 10

E. End. bridge D 1225.12

W. End bridge D 1412.85