
10-17-97 SJT, EJM

60

E¼ cor Sec 31-101-18

Searched area by hand & Fd remains of old wood CFP. No further evidence of orig. PLS corner was found. Accepted location of fence corner as best remaining evidence of perpetuation of orig. PLS corner. Set CIM.

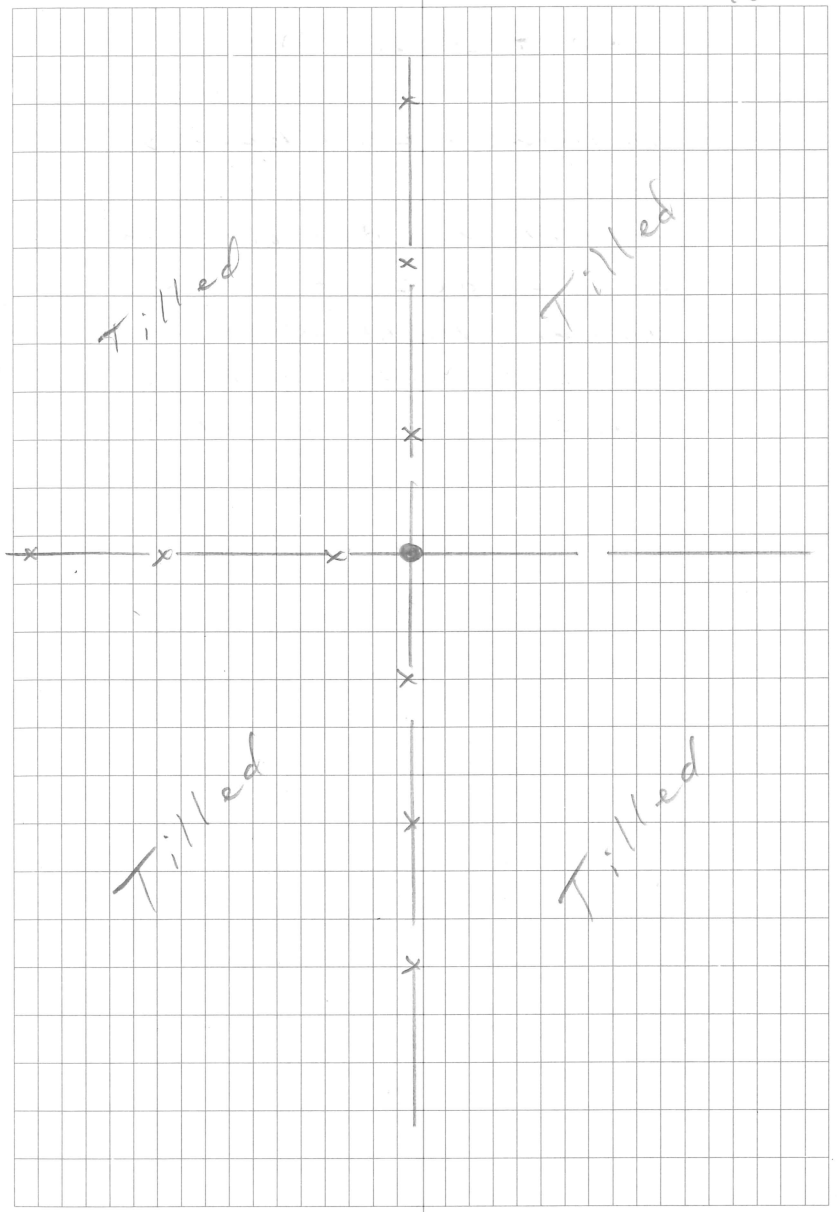

E¼ COR SEC. 31 - 101 - 18

THIS CREW SET CORNER.
PLACED CIM.

SEE Book 438 pg 28
MONTOUR CO. R/W PLAT No. 15

1-27-03 HLS

74

