SE COR SEC. 31- 101-18


NO INFORMATION FOUND IN MOWER CO. RECORDS.


JHS CREW dug with MOWER CO. BACKHOE, Dug a 4'x12' HOLE to virgin soil, on ℄ STATE LINE ROAD & ℄ of TWP Rd NORTH, AND FOUND NO EVIDENCE of PLS CORNER.

SET CORNER ON STRAIGHT LINE BETWEEN SW & SE CORNERS, AS SPLIT-CORNER FITS ℄ of TWP Rd. NORTH.

SET 5/8" X 16" IRON with CAST IRON MON.

7-1-97 Cloudy 85° HLS ADM 56

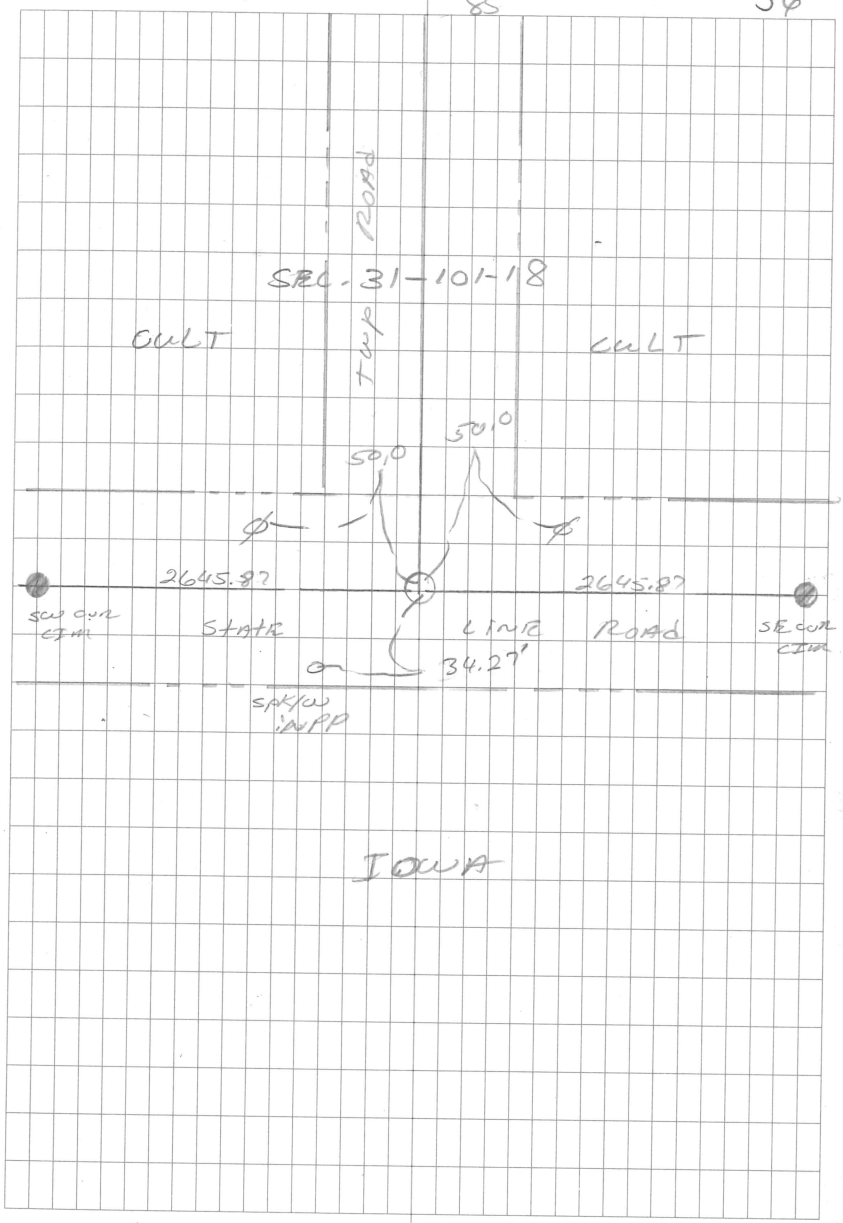

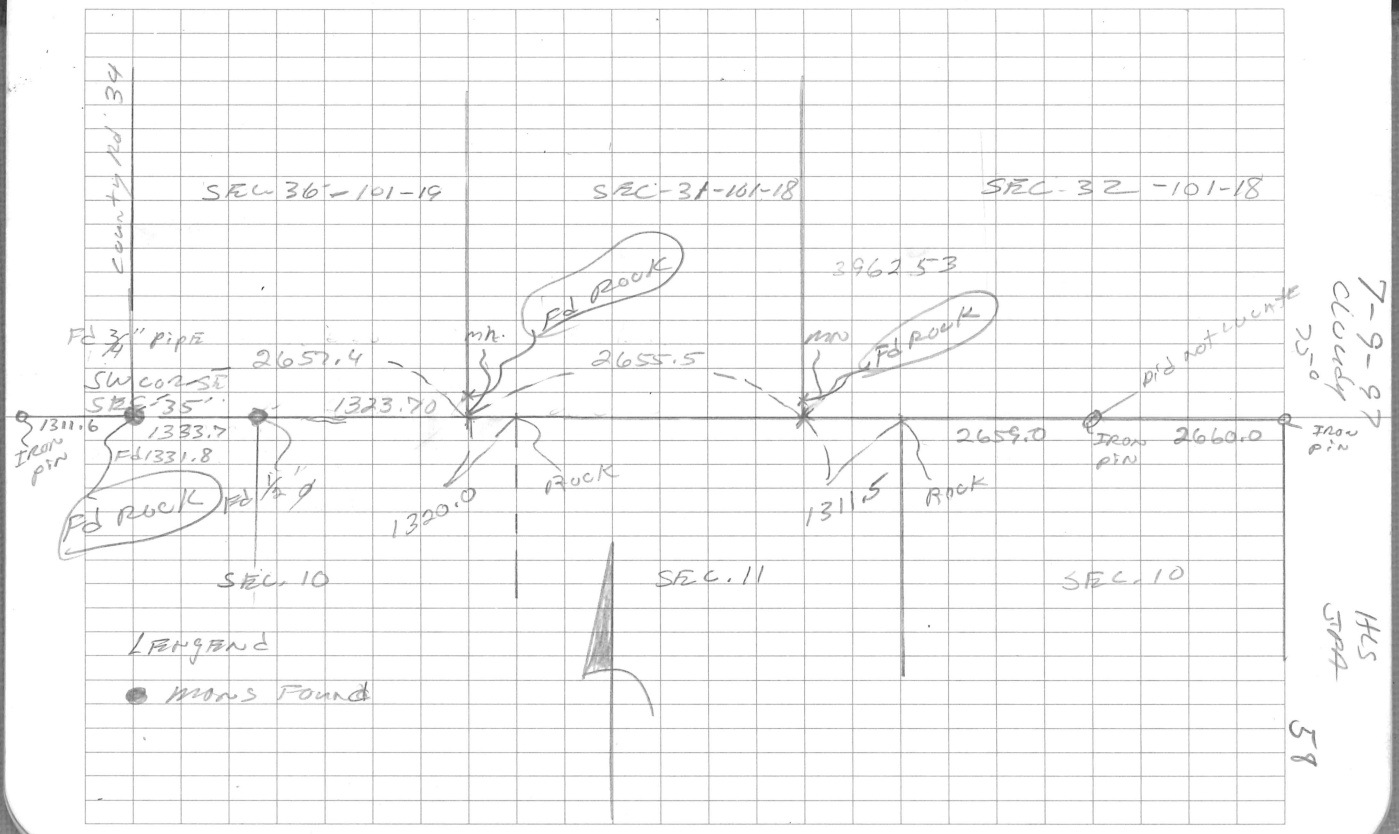
SEC 36 - 101 - 19
SEC - 31 - 101 - 18
SEC - 32 - 101 - 18
County Rd 34
Fd 3" pipe
SW cor SE SEC 35
1311.6
IRON PIN
1333.7
Fd 1331.8
Fd ROCK
Fd 1½"
2657.4
1323.70
mh.
Fd ROCK
2655.5
2962.53
mh
Fd ROCK
did not locate
IRON PIN
2659.0
2660.0
IRON PIN
1320.0
ROCK
1311.5
ROCK
SEC. 10
SEC. 11
SEC. 10
LEGEND
Irons Found
7-9-97
Cloudy
70's
14LS
STAFF
58