SW cor SEC. 32 - 101 - 18

NO INFORMATION FOUND IN MOWER Co. RECORDS

1942 JOHN NEILSEN RECORDS STATE HE FOUND ROCK @ SE cor SEC. 36 - 101 - 19


JHS CREW DUG with MOWER Co. BACKHOE on ℄ of ROAD AND IN LINE with LINE FENCE North. Dug on 8'X10' hole, UNCOVERED a 2'X1½ ROCK. AT 2' BELOW ROAD SURFACE, ROCK is ON ℄ of ROAD & IN LINE with LINE FENCE North. ACCEPTED ROCK AS TRUE PLS CORNER, PLACED ⅝"X16" IRON ON WEST SIDE of ROCK FOUND, SET ⅞"X16" IRON over ROCK with CAST IRON MON. .40 BELOW ROAD SURFACE


CAPPED - NO. 13807

Fd 4'± S of ℄ Rd 10-17-97 SJT

7-1-97 CCounty 85° HLS ADM

55

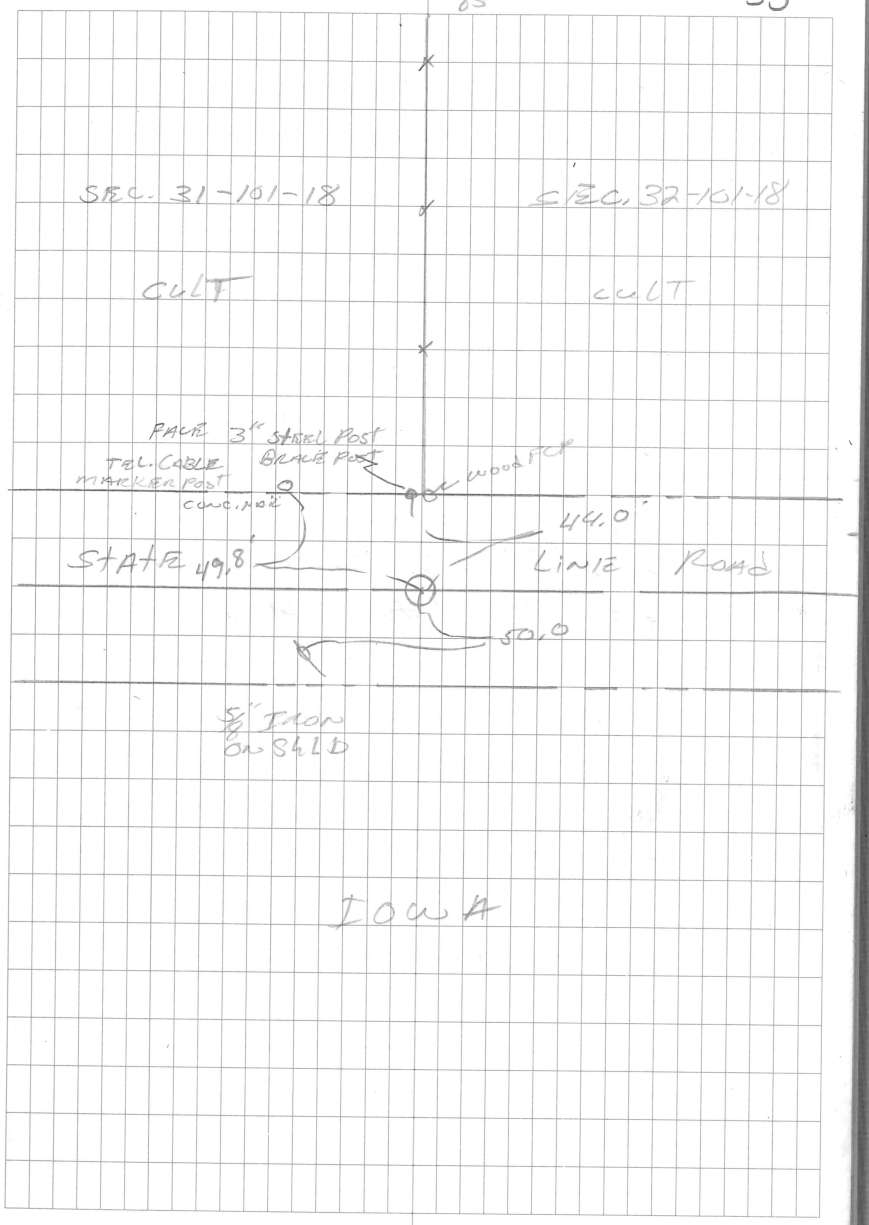

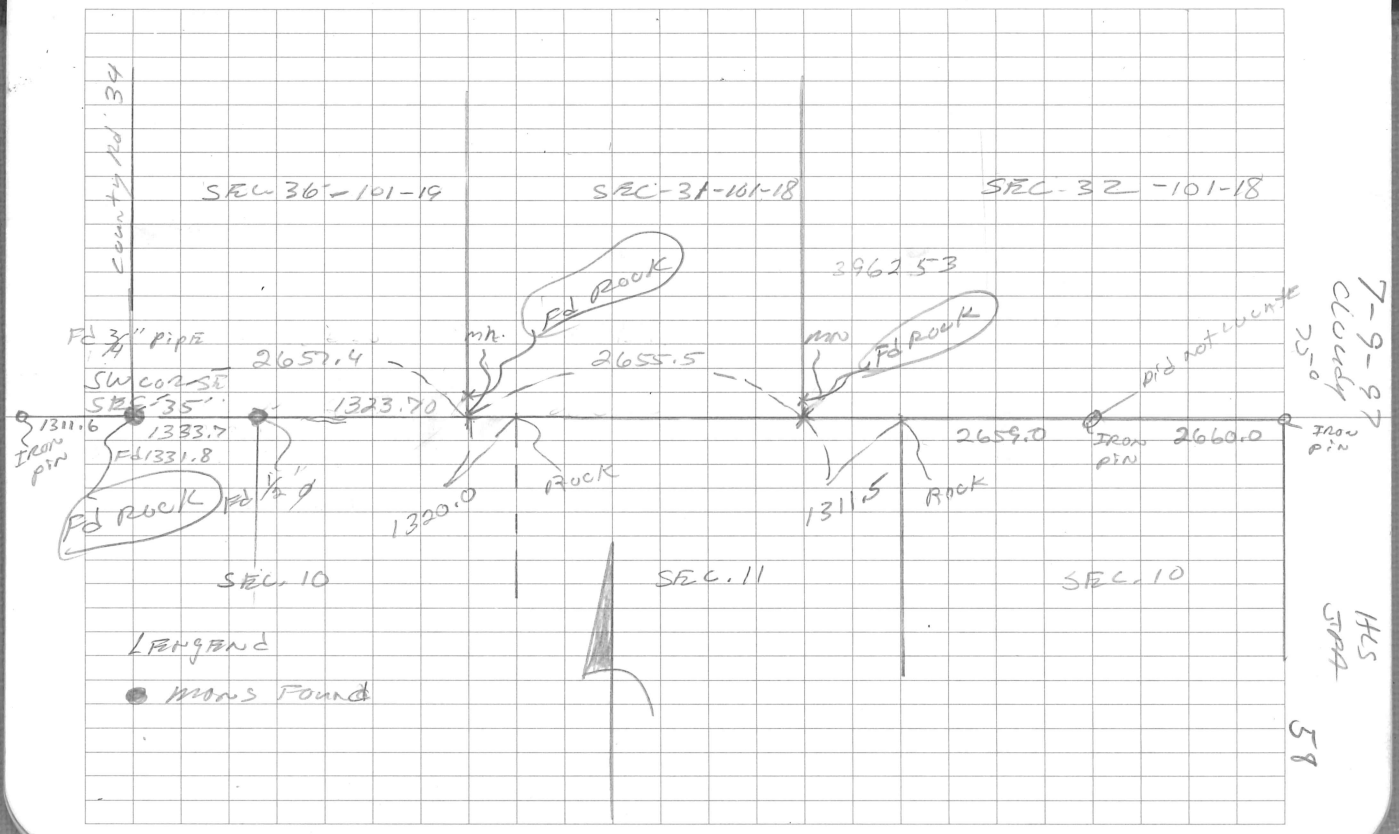
SEC 36 - 101 - 19
SEC - 31 - 101 - 18
SEC - 32 - 101 - 18
County Rd 34
Fd 3" pipe
SW cor SE SEC 35
1311.6
IRON PIN
1333.7
Fd 1331.8
Fd ROCK
Fd 1½"
2657.4
1323.70
mh.
Fd ROCK
2655.5
2962.53
mh
Fd ROCK
did not locate
IRON PIN
2659.0
2660.0
IRON PIN
1320.0
ROCK
1311.5
ROCK
SEC. 10
SEC. 11
SEC. 10
LEGEND
Irons Found
7-9-97
Cloudy
70's
14LS
STAFF
58