SW 31-101-18


JOHN NEILSEN RECORDS STATE, HE UNCOVERED ROCK WITH SMALLER ROCK ARound, 2.3' N. of IOWA SECTION LINE, 4'± NORTH of ROAD SHLD.


JHS CREW DUG with MOWER Co. BACKHOE ON ℄ of ROAD AND IN LINE with LINE FENCE UNCOVERED ROCK, DUG by HAND AND FOUND SMALL ROCK on SIDES. ROCK FIT LINE FENCE NORTH AND 5.0± NORTH of SOUTH ROAD SHLD. ACCEPTED ROCK AS TRUE CORNER - SET 5/8"ø CAP. NO. 13807 ON WEST SIDE of ROCK, SET 5/8"x16" IRON with CAST IRON MON OVER ROCK FOUND

BS	SW cor	BS SE cor
D	~~5291.04~~	5291.74
FS	S¼ cor	
+	00°00'00"	
D	~~2645.52~~	2645.87
BS	POL	
D	4307.91	

7-1-87
Cloudy
85°
HCS
AOM

54

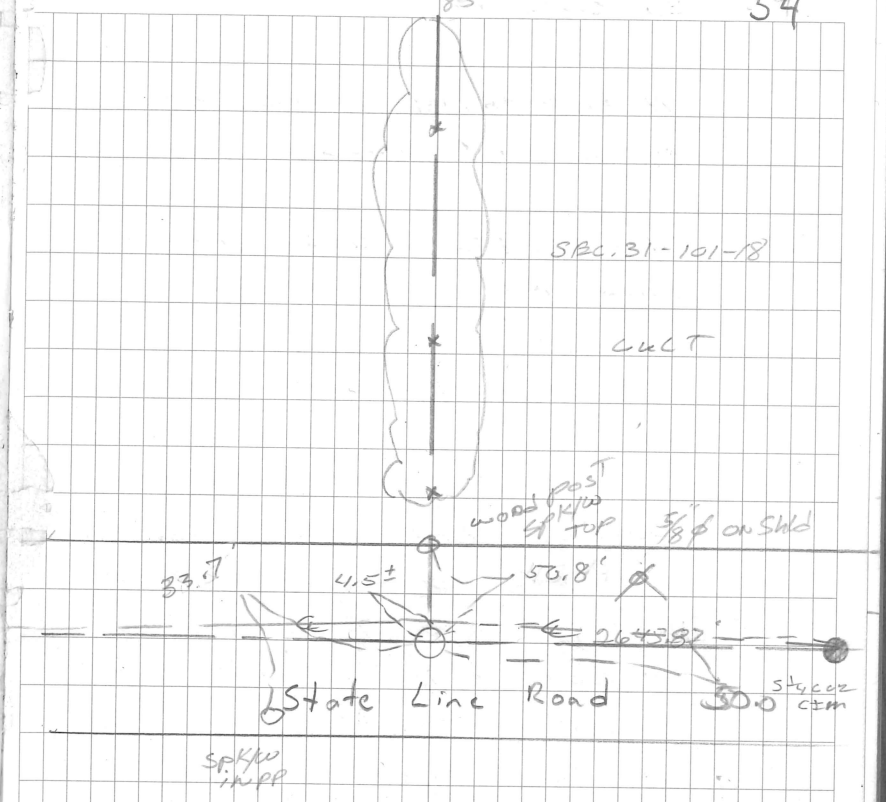

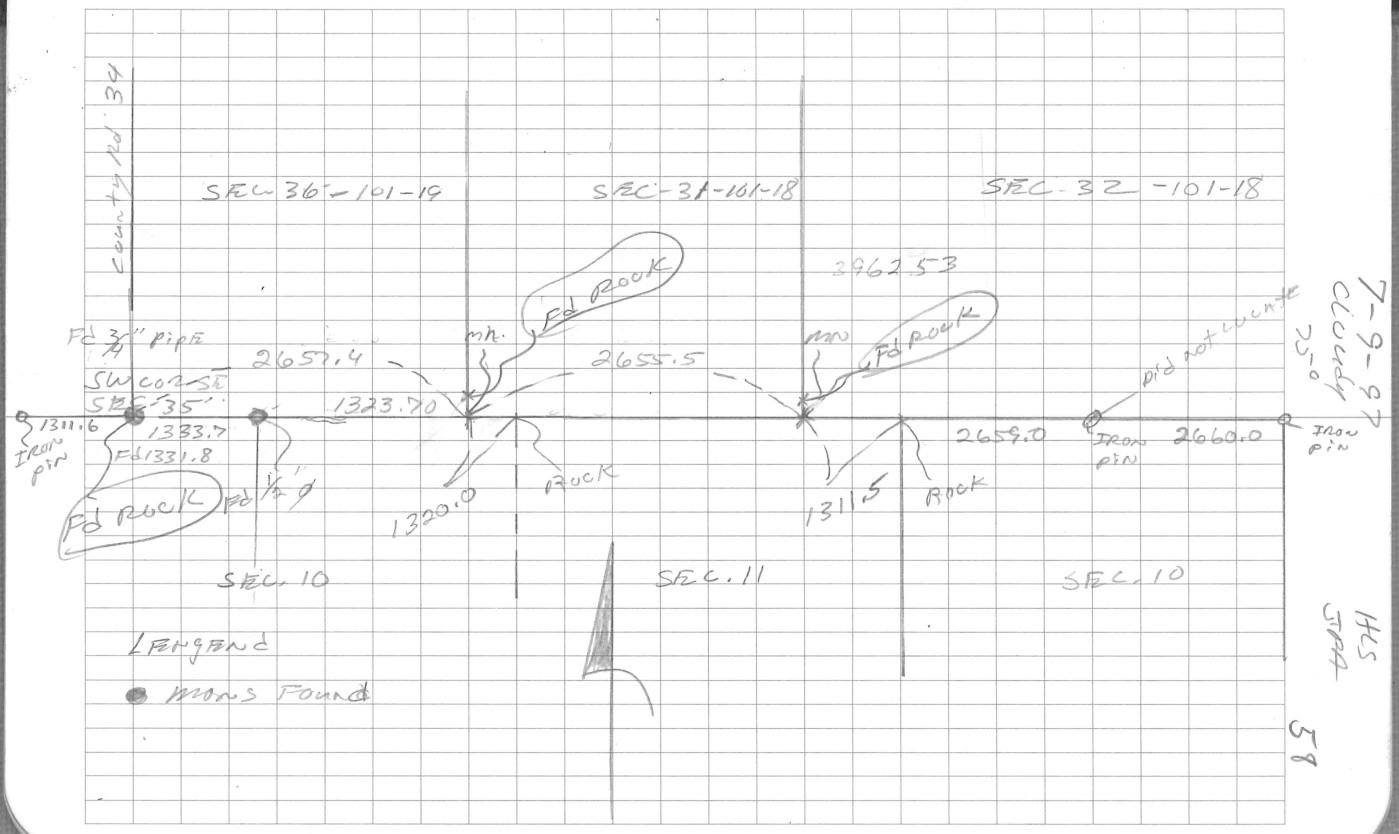
SEC 36 - 101 - 19
SEC - 31 - 101 - 18
SEC - 32 - 101 - 18
County Rd 34
Fd 3" pipe
SW cor SE SEC 35
1311.6
IRON PIN
1333.7
Fd 1331.8
Fd ROCK
Fd 1½"
2657.4
1323.70
mh.
Fd ROCK
2655.5
2962.53
mh
Fd ROCK
did not locate
IRON PIN
2659.0
2660.0
IRON PIN
1320.0
ROCK
1311.5
ROCK
SEC. 10
SEC. 11
SEC. 10
LEGEND
Irons Found
7-9-97
Cloudy
70's
14LS
STAFF
58