
10-17-97 SJT. ENM

59

W 1/4 cor Sec 31-101-18

Excav. area by hand &
Fd no further evidence of
perpetuation of PLS corner.
Set CIM @ Lost position, which
Fit existing fence lines. Accepted
as best evidence of location of
orig. PLS corner.

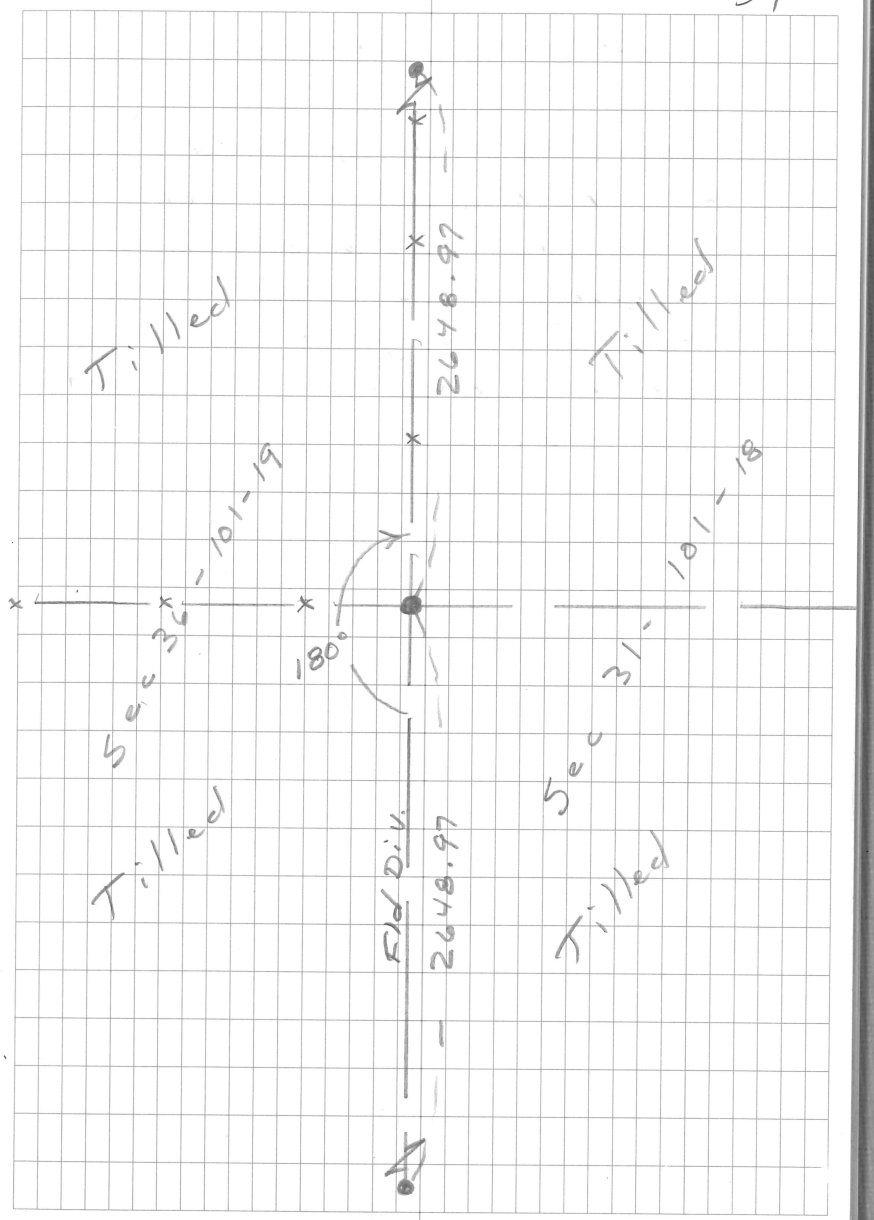

W¼ corn SEC. 31-101-18

JHS CREW SET CORNER
PLACED CIM.

SEE Book 438 - pg 28
MOWER CO. R/W PLAT No. 15

1-27-03 HLS

