7-1-97
Cloudy 65°

HLS
ADM

57


S¼ cor SEC. 32 - 101 - 18


NO INFORMATION FOUND IN MOWER CO. RECORDS.

THS CREW Dug with MOWER County BACKHOE, Dug on ℄ LINE of ROAD @ split BETWEEN SW COR & SE cor.

Dug a 6'X12' hole 4'± DEEP TO virgin SOIL, AND FOUND NO EVIDENCE of PLS CORNER.

SET cor AT split & STRAIGHT LINE BETWEEN SW COR & SE cor

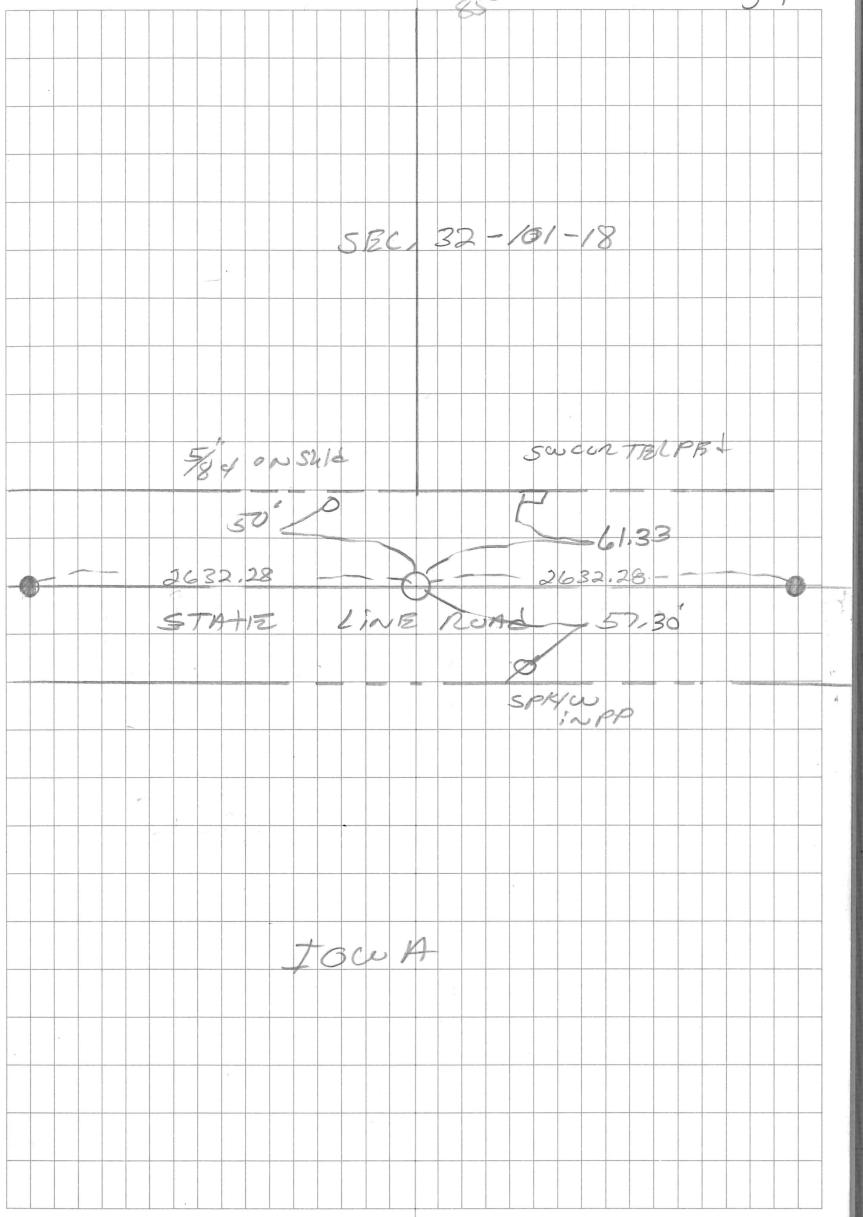

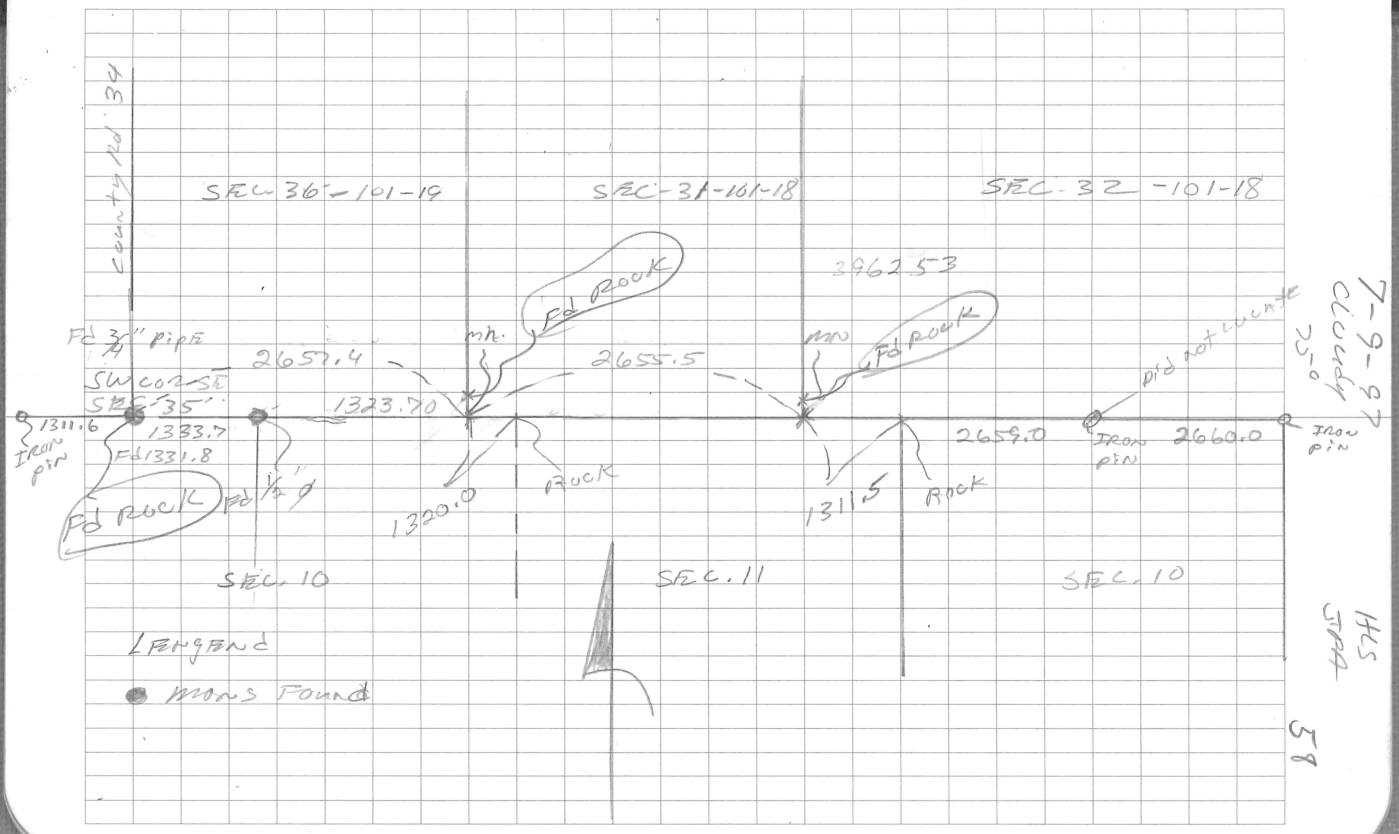
SEC 36 - 101 - 19
SEC - 31 - 101 - 18
SEC - 32 - 101 - 18
County Rd 34
Fd 3" pipe
SW cor SE SEC 35
1311.6
IRON PIN
1333.7
Fd 1331.8
Fd ROCK
Fd 1½"
2657.4
1323.70
mh.
Fd ROCK
2655.5
2962.53
mh
Fd ROCK
did not locate
IRON PIN
2659.0
2660.0
IRON PIN
1320.0
ROCK
1311.5
ROCK
SEC. 10
SEC. 11
SEC. 10
LEGEND
Irons Found
7-9-97
Cloudy
70's
14LS
STAFF
58