SW cor 33 - 101 - 18

TH 105 Hwy plan shows mon @ Cor on E X'n

JHS crew used cor for survey
See B294 P27


Fd Pk nail on surface over 3/4" drill hole +- 0.5' down on E N & S's of E E-W HLS TRS


8-7-97 JHS CREW dug with MOWER & Co. BACKHOE, UNCOVERED @ 3/4" X 3.4' IRON with 2"x2" STAKE ON South side. FOUND NO OTHER EVIDENCE of PLS CORNER. ACCEPTED IRON FOUND AS TRUE CORNER.

LEFT IRON AS FOUND, SET 5/8" X 16" IRON with CAST IRON MON. AT ROAD SURFACE.

8-9-96 SJT, TRS

50'

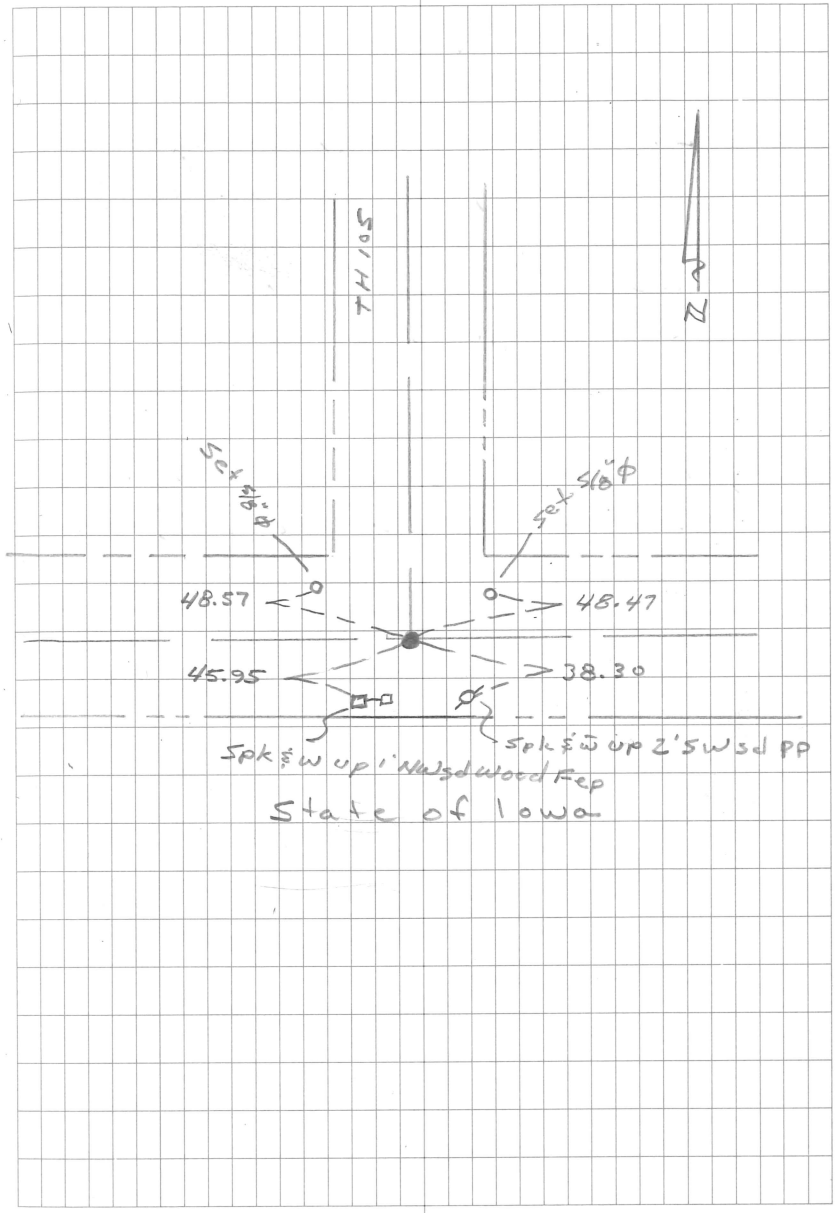

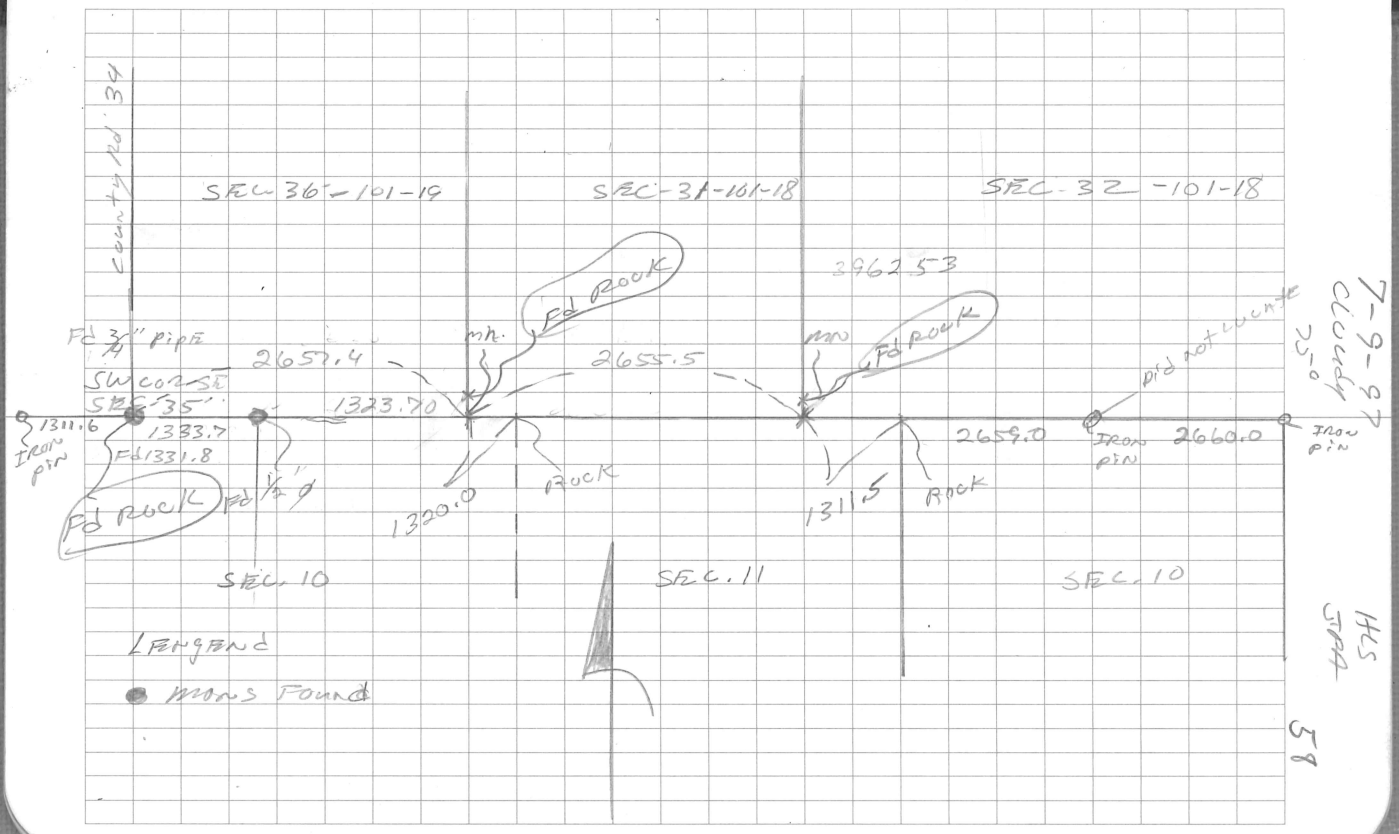
SEC 36 - 101 - 19
SEC - 31 - 101 - 18
SEC - 32 - 101 - 18
County Rd 34
Fd 3" pipe
SW cor SE SEC 35
1311.6
IRON PIN
1333.7
Fd 1331.8
Fd ROCK
Fd 1½"
2657.4
1323.70
mh.
Fd ROCK
2655.5
2962.53
mh
Fd ROCK
did not locate
IRON PIN
2659.0
2660.0
IRON PIN
1320.0
ROCK
1311.5
ROCK
SEC. 10
SEC. 11
SEC. 10
LEGEND
Irons Found
7-9-97
Cloudy
70's
14LS
STAFF
58