
NE Cor Sec 1-102-14
cert. Filed 4-3-91 by JHS

Dug on ℄ E-W road in line with field division north and uncovered a 1/2"ϕ iron in conc. 0.7' below road surface, left mon. as found

3-2-06 MHS SES Found 1/2 IRON Shot with GPS For BASEMAP

3-11-91 DRR/HLS 3.

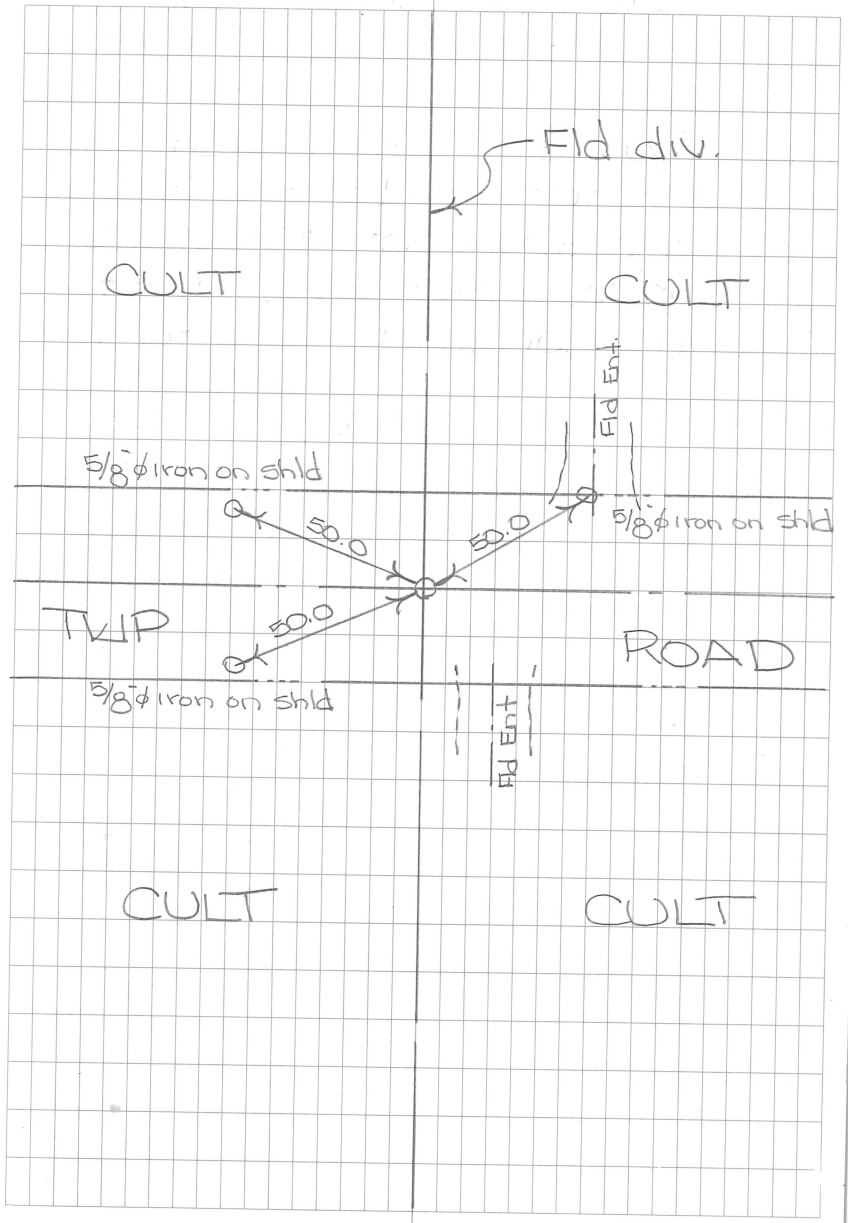

NE Cor Sec 1-102-14

Dug on ℄ E-W road in line with field division north and uncovered a 1/2 ϕ iron in conc. 0.7' below road surface, left mon as found

Ties 5/8 ϕ x 16" irons on shoulders

3-11-91 DRR HLS 48

