N 1/4 SEC 5-102-14


Cert. Filed by JHS

CORNER SET BY JEROME SCHWARZ

NO RECORD OF CORNER, PROPERTY OWNER SE OF CORNER AREA TOLD CREW THAT A TILE LINE HAD BEEN DUG IN DEEP AND IN THE ℄ OF THE ROAD ± 10 YEARS AGO, CHECKED WITH METAL LOCATOR - FOUND NOTHING, SET 5/8" x 18" IRON PIPE DOWN 0.5'

3-2-06 Found 5/8 pipe Shot with GPS
MHS FOR BASEMAP
SES

6-24-99 42

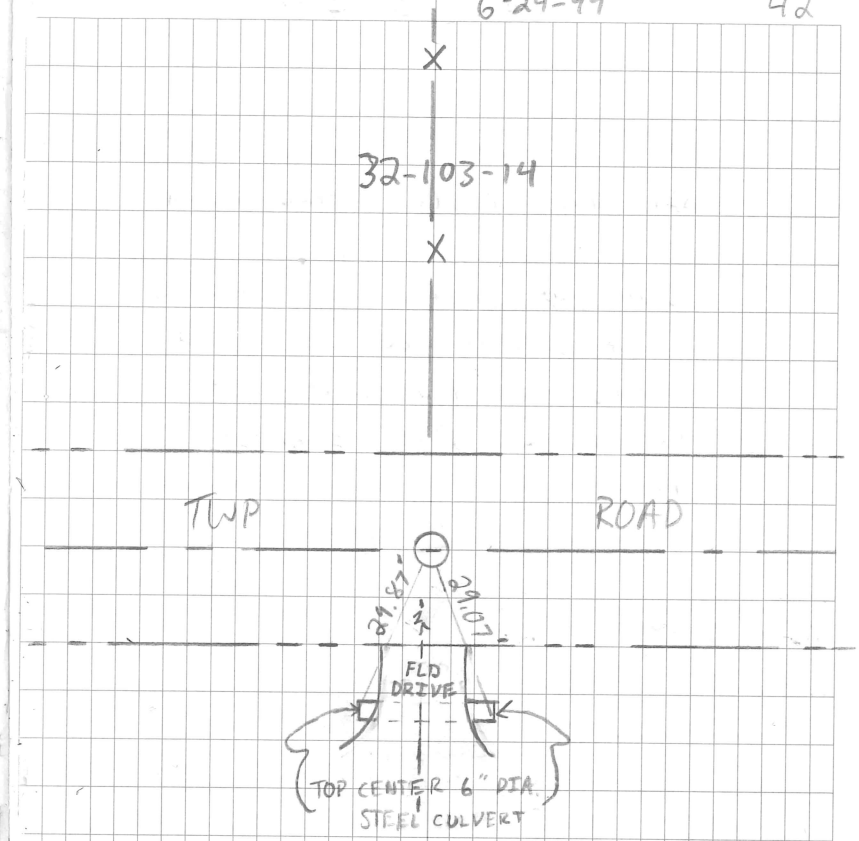

5-102-14