NE COR 5-102-14

Cert. Filed by JHS

CORNER SET BY JEROME SCHWARZ

NO RECORD OF CORNER. DUG WITH A BACK HOE A HOLE 8'x8'x4' DEEP TO VIRGIN SOIL AND FOUND NO EVIDENCE OF PLS. CORNER.

SET CORNER FOR N-S: DOUBLED THE DISTANCE FROM THE NORTH BETWEEN 1/4 CORNER OCCUPATION AND 1/16th CORNER OCCUPATION.


SET CORNER FOR E-W: SET CORNER AT EVEN SPLIT OF 1/4 CORNER OCCUPATION 1/2 MILE WEST AND 1/2 MILE EAST.

SET 1"x20" IRON PIPE DOWN 0.5'

3-2-06	Found 1" Pipe Shot with GPS
MHS	FOR BASEMAP
SES	

6-24-99

41

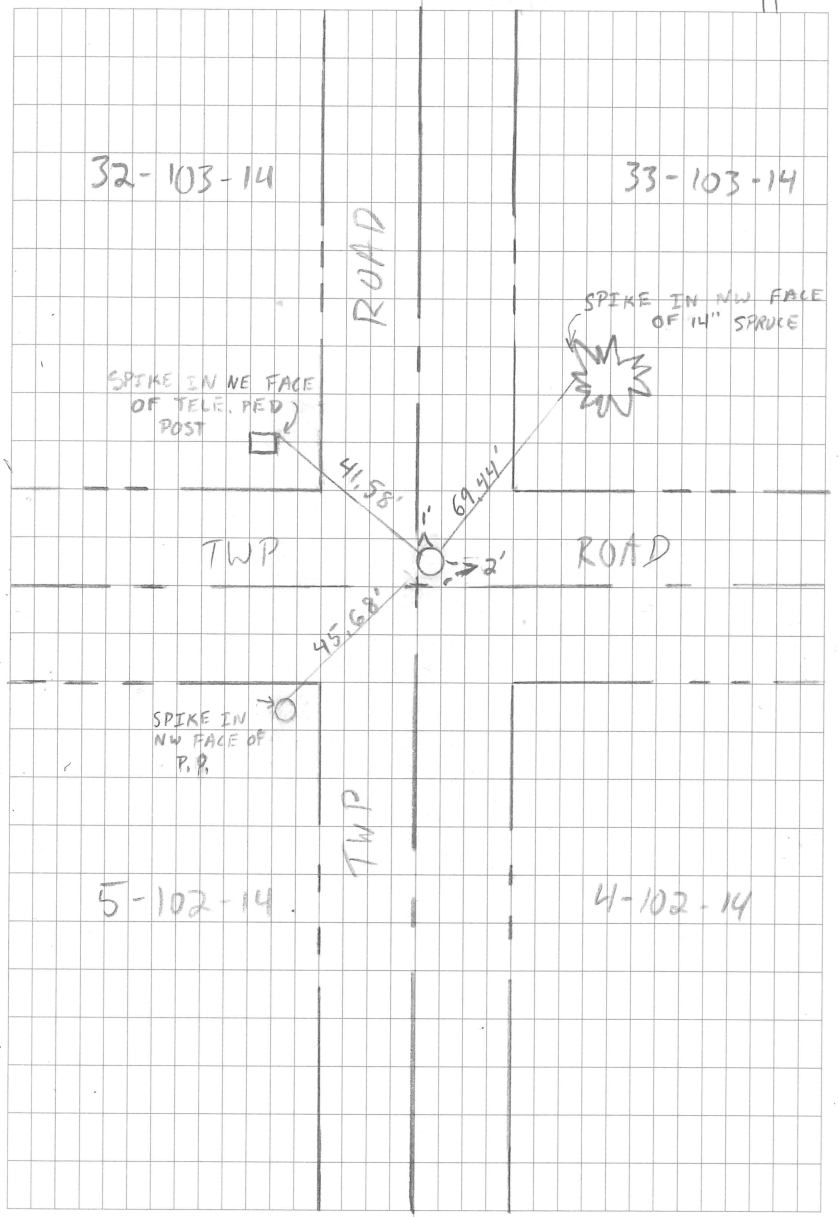

SW COR SEC. 33 - 103 - 14

NO INFORMATION FOUND IN MOWER CO CORNER RECORDS

THIS CREW dug by HAND AND UNCOVERED 1" PIPE .80± BELOW ROAD SURFACE.

FOUND NO RECORDS - AS WHO OR HOW IT WAS SET. MAY NEED TO dig.

10-30-01 CLOUDY 50° HCS ADM

41

