8-5-97
CLEAR
75


HLS
TRS

24

E¼ cor SEC. 10-102-14

NO Information Found
IN Mower Co. Records.

(NEED to SET)

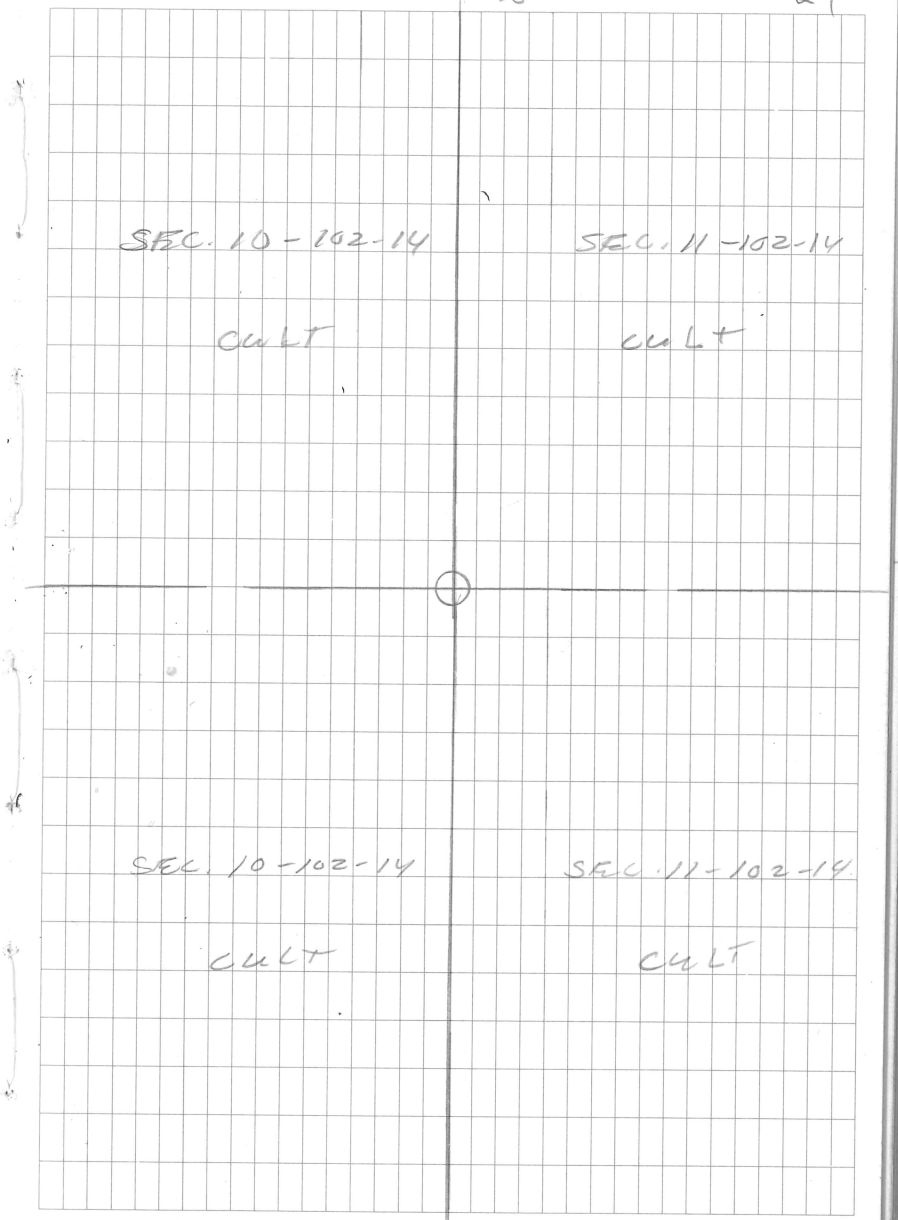

10-19-06 SHS 46

W 1/4 COR SEC 11

SHOT 4 WAY FENCE INTER IN THIS LOC

