
NE COR SEC 23

1941 & 1971 ROAD GRADING PLANS SHOW CONC MON @ THIS LOCATION
JHS CREW DUG @ THIS LOC. & FOUND HARRISON CAST IRON MON 1.5' BELOW ROAD SURFACE WHICH CHECKED WITH DIST. ON CO ROAD GRADING PLAN. LEFT MON INPLACE & TIED IN WITH GPS.

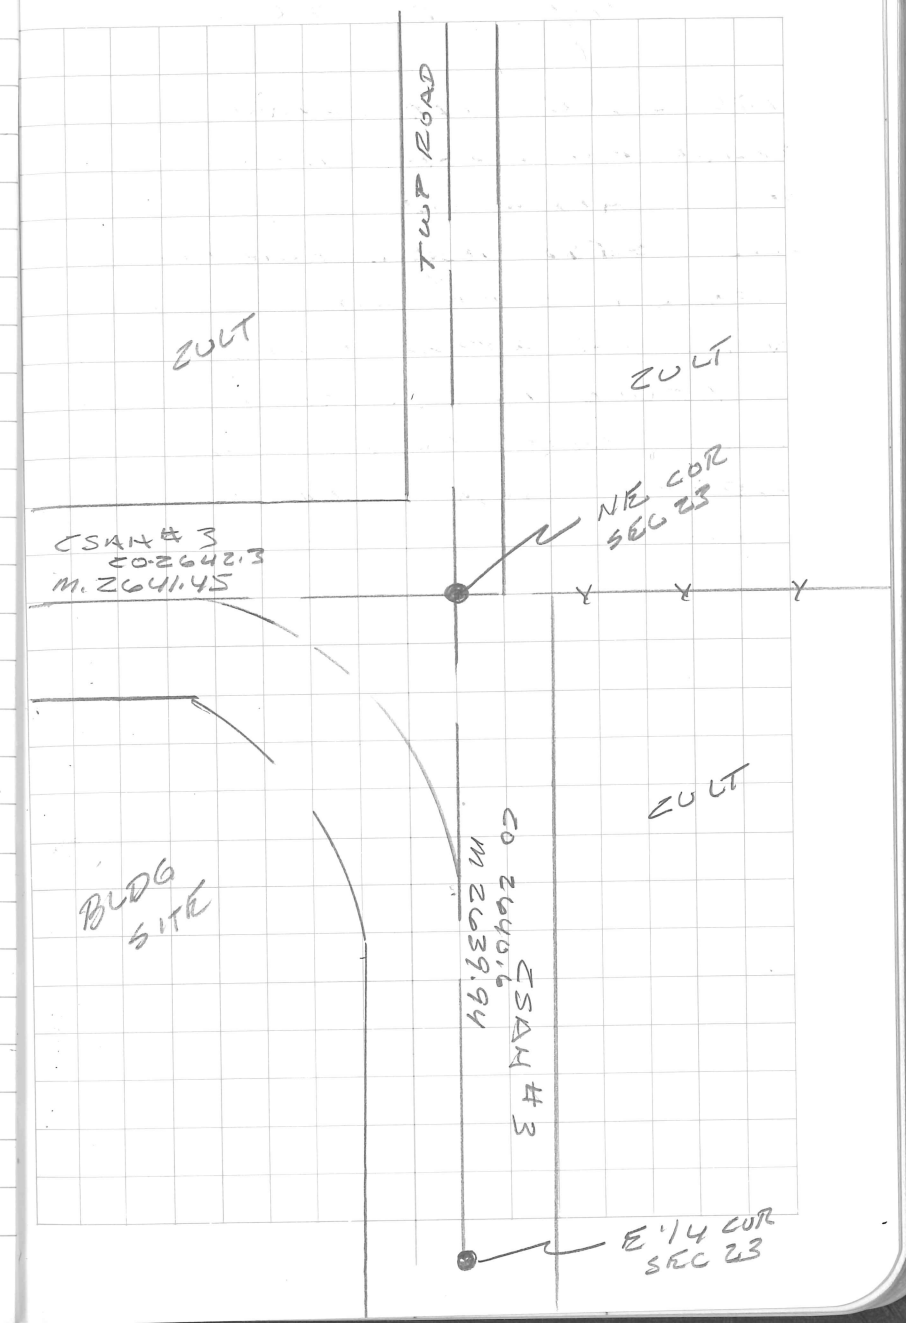

N 1/4 COR SEC 23