E 1/4 COR. SEC. 28-102-14

MOWER CO RECORDS SHOW AN INPLACED CONC. MON.


DUG W/ MOWER CO. BACKHOE TO A DEPTH OF 5' AND FOUND NO EVIDENCE OF ORIGINAL PLS CORNER MARK E OF ROAD. CORNER WILL BE SET LATER.

6-16-00 JAS
SET 5/8"Ø IRON ON STRAIGHT LINE BETWEEN SEC CORS @ PROPORTIONAL DIST TO MOWER CO. CSAH #14 ROAD PLAN

5-1-04 CPU EJL Reset Monument after Regrading Project using GPS. Set a survey Pin @ this location.

5-16-00 TRS 650 CLOUDY

43

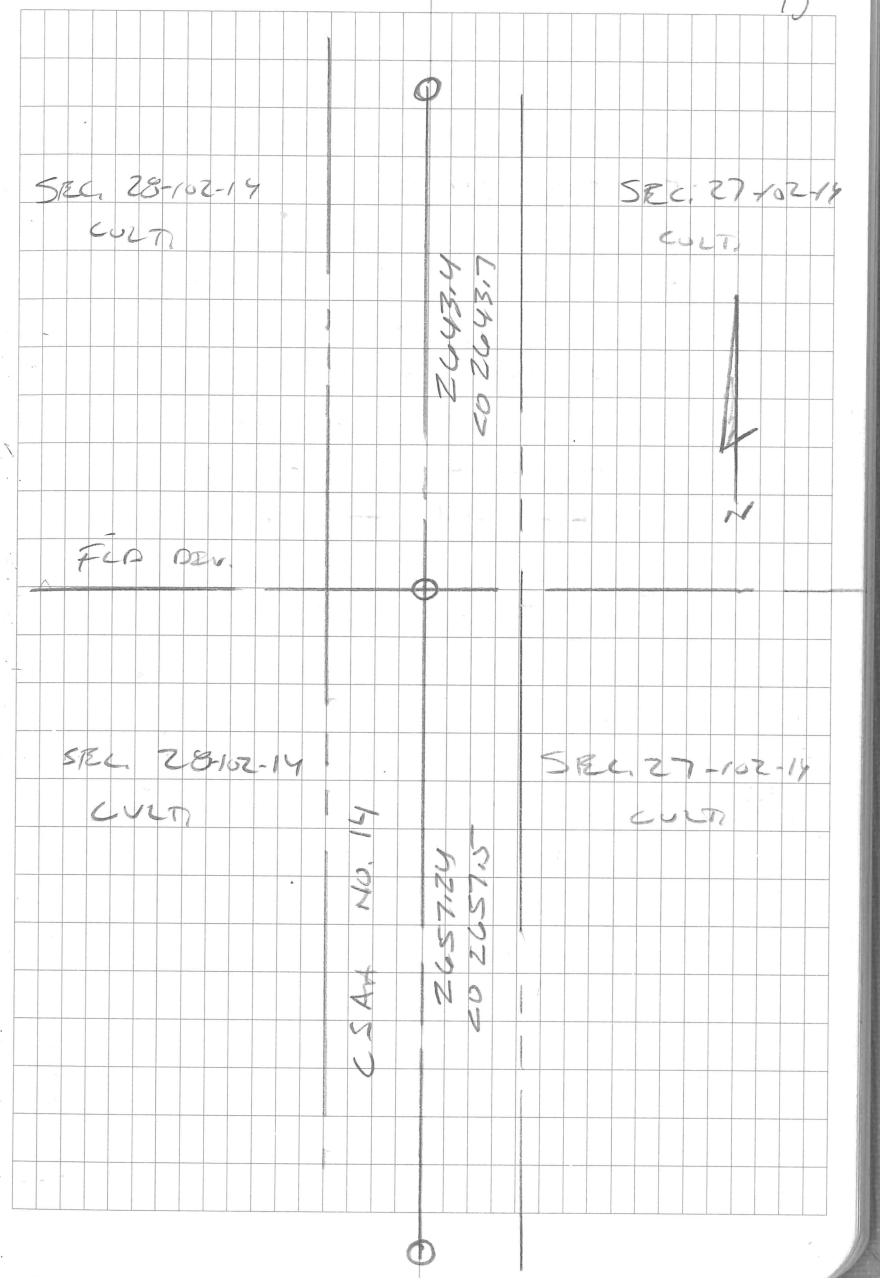

7-31-97
Cloudy
80°

HKS
ADMS

Wtr cor SEC. 27-T02-14

te POL
BS NW cor SEC. 27
D 4403.25
FS SW cor SEC. 27
+ 180°00'00"
D 896.81
FS wtr cor SEC. 27
+ 00°00'00"
D 1758.98
– 1745.18 1745.18
13.80

