E 1/4 CORNER SEC 33-102-14

DUG W/ MOWER CO. BACKHOE AND FOUND NO EVIDENCE OF ORIGINAL PLS CORNER AT APPROX SOIL. LEFT AS FOUND AND PLACED NOTHING.


6-16-00 JAS
SET 5/8"ø IRON ON STRAIGHT LINE BETWEEN SEC CORS @ PROPORTIONAL DIST TO MONUM CO CSAH 14 ROAD PLAN

5-1-04 Reset Monument after Regrading
CPU Project using GPS.
EJL Set a survey Pin @ this location.

5-16-00
70°
PC

TRS

45

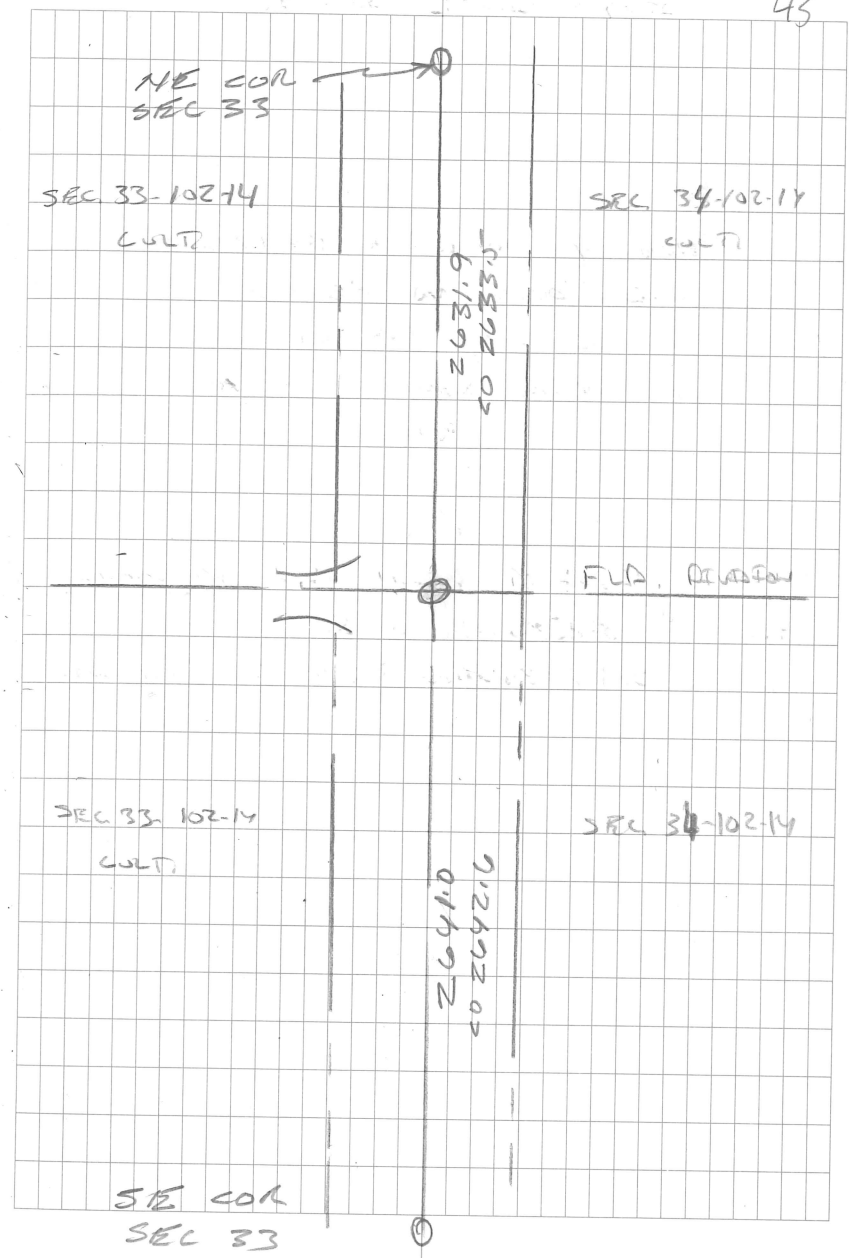

7-31-87
Cloudy
80°

HLS
AOM

13

W¼ cor SEC. 34 – 102-14

To SW cor SEC 34
FS NW cor SEC. 34
D 5272.34
FS W¼ cor SEC. 34
+ correction
D 2639.72

NO INFORMATION FOUND IN
MOWER CO. RECORDS.

