
N 1/4 COR SEC 14

NO RECORD OF THIS COR IN MOWER CO HWY DEPT OFFICE

COMPUTED POS. OF THIS COR W INTER OR A STRAIGHT LINE BET NW & NE COR OF SEC 14 & SLY EXT OF LINE FROM N 1/4 COR OF SEC 11 THRU CFD ⊃ CNT OF SEC 11. THIS ALSO FITS EXISTING FLD DIV OR TO NORTH & MIDPT OF ST LINE BET NW & NE CORS SEC 14

4/12/06 Set Cone Nail

3-7-06 JHS

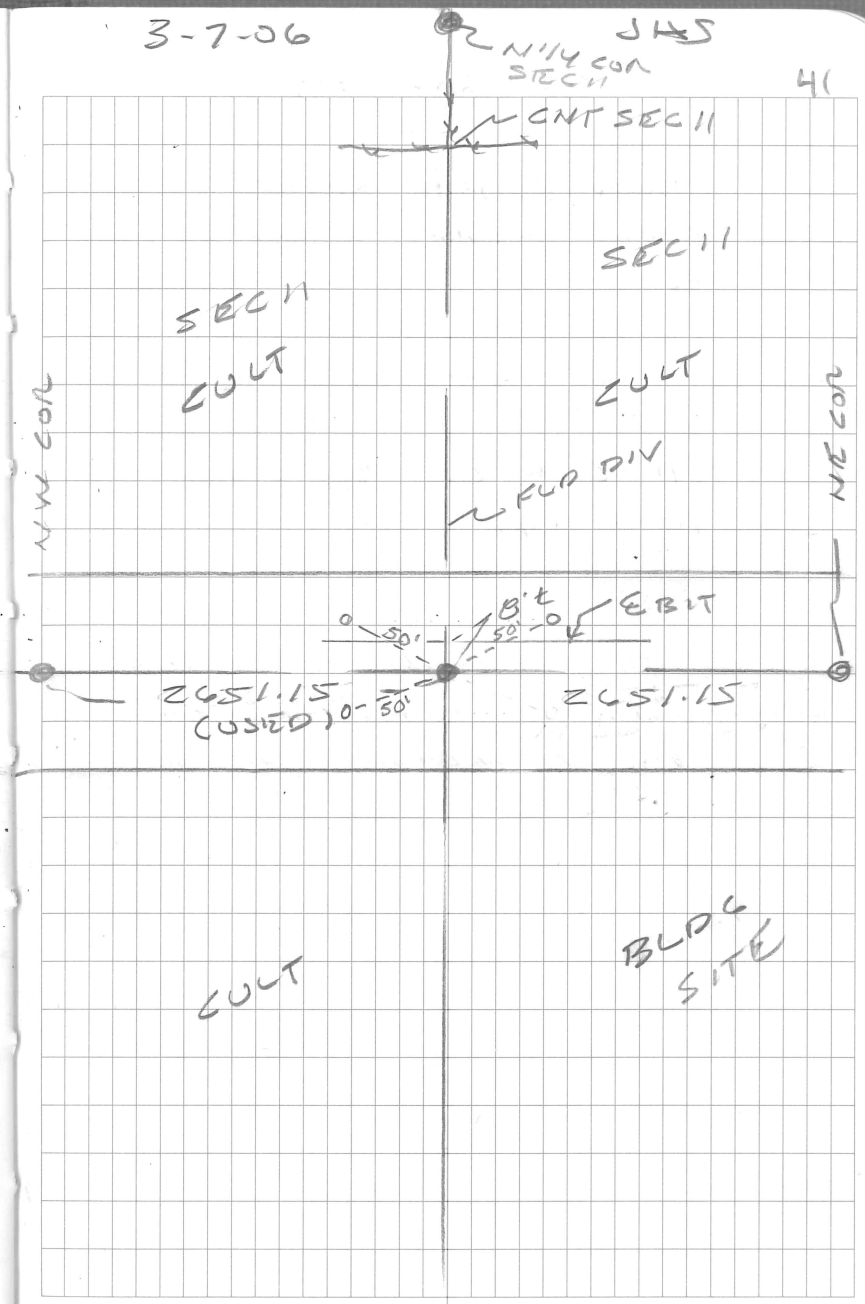

41