7-14-05
CLEAR


HLS
MHS

35

E¼ COR SEC. 3 - 102-16

FOUND BI2NE ⅝"ø

DUG WITH BOIE BROS. BACKHOE
AT LOCATION OF ⅝"ø
REMOVED ⅝"ø AND DUG
BELOW AND FOUND NO
OTHER EVIDENCE OF PLS
COR.
RESET ⅝"ø AT SAME
LOCATION AND PLACED
CAST IRON MON. OVER ⅝"ø
60± BELOW RD SURFACE

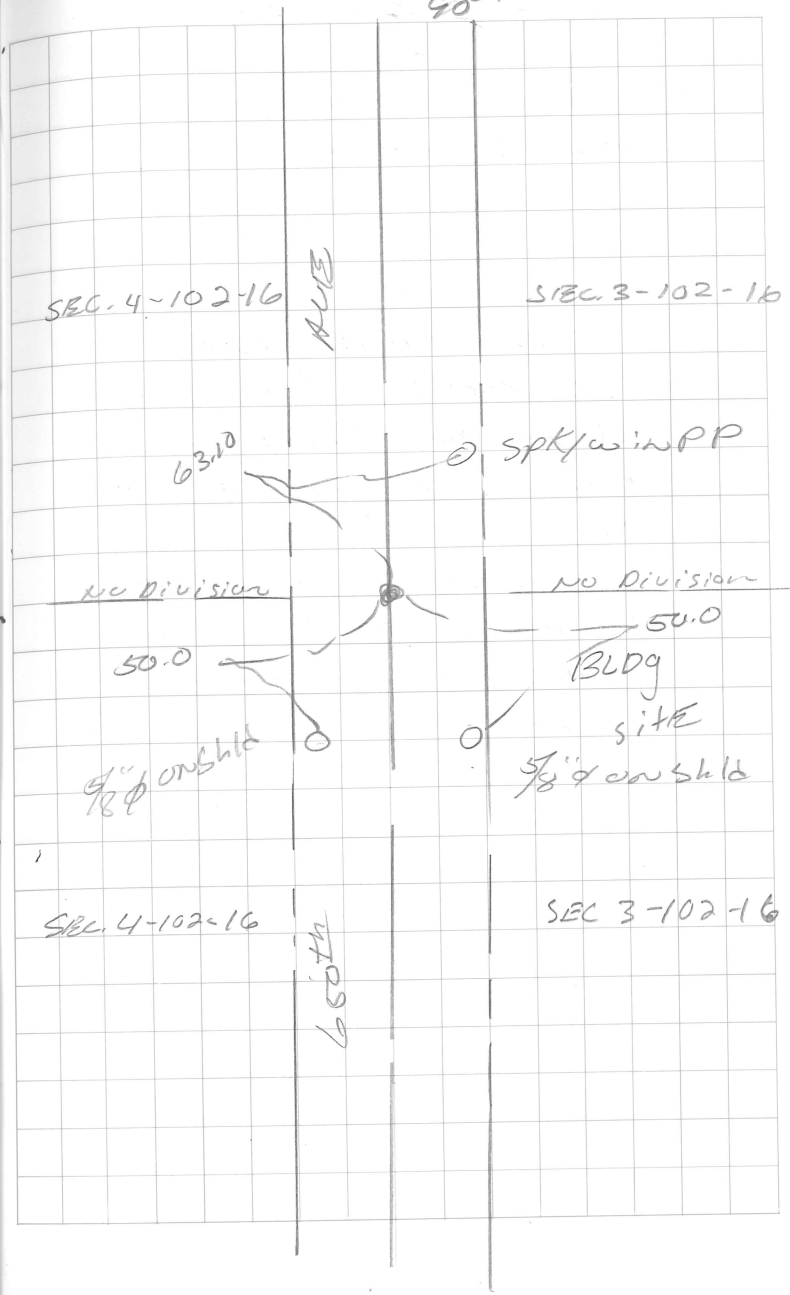

W 1/4 Cor Sec 2-102-16

See Book 208 pg 72
Dug 8' x 4' x 14'. Fd
Field Stone 3' Deep Placed
1" Bar over

6/1/05 Fd 1" Bar Bent to North

