
5-10-91 DRR/RMK ✓2

N1/4 Cor Sec 3-102-16
cert. Filed 5-16-91 by JHS
Dug on ℄ Road with
Co. backhoe for bitum.
overlay Project #
SAP # 150-613-08

Dug a 4'x 7'x 6' deep
hole and uncovered
a 1/2"ϕ pipe 0.5' deep
over a a 10" dia. x
18" conc. mon. w. 1"ϕ
iron cast, in CTR 4' below
road surface in virgin
soil. cont. digging and
found no further evidence
of a PLS corner, reset
conc. mon. and set
CIM over it on road
surface.

Pipe was 0.3' W ℄ 0.55
So. of Conc. mon.

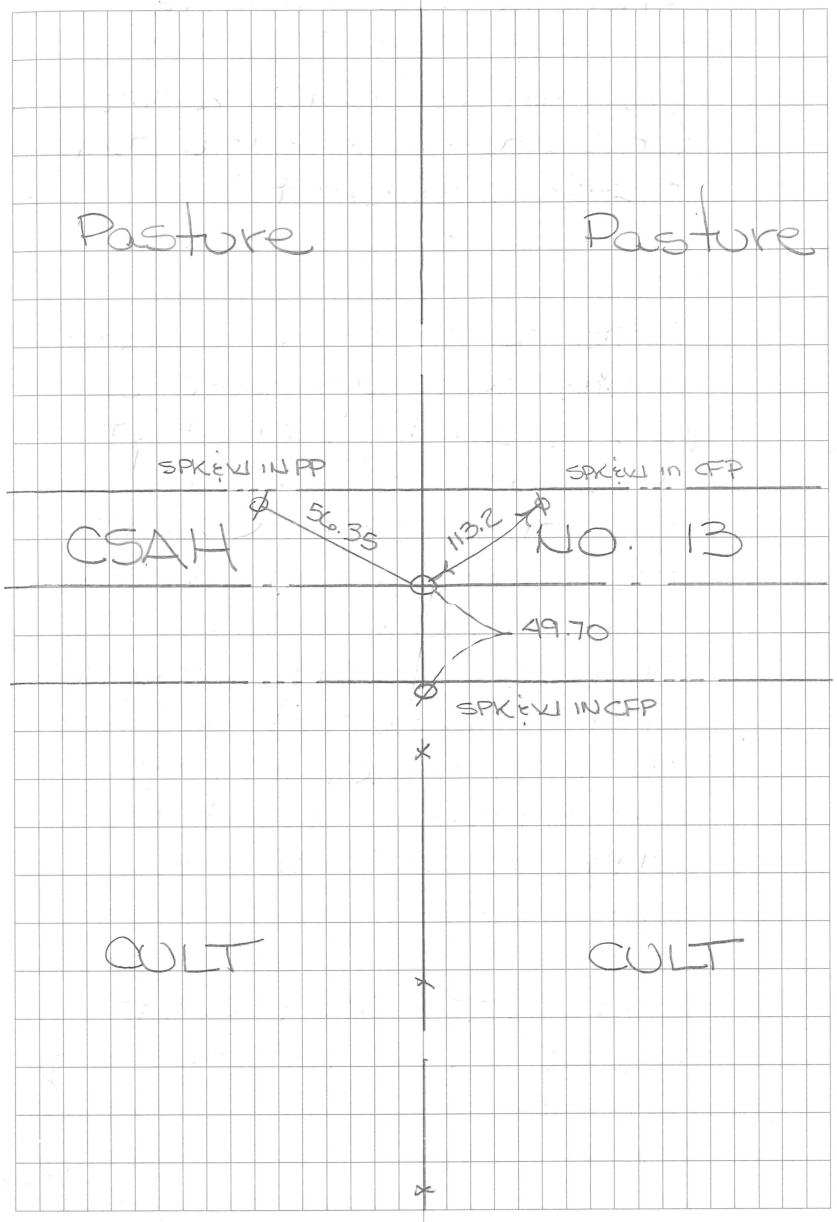

S 1/4 SEC 34

10-10-02 F 5/8"
SEE BOOK 20 @ PG # 40

10-10-02 JHS

