
5-10-91 DRR/RMK 3

NW1 Cor Sec 2-102-16
cert. Filed 5-16-91 by JHS
Dug with Co. backhoe
for bitum. overlay project
#SAP 50-613-08

Dug a 4'x 10'x 3' deep
hole N-S and uncovered
a 3/4" ϕ iron 0.9' deep on
Ext (Co. PI) dug at
a point 8' So. at
location of PK nail
flush on road surface
and uncovered a
5/8" ϕ iron cont. digging
and uncovered a
10" dia. conc. mon.
w/ 3/4" ϕ iron cast in
ctr on S. side of
old spoke post. left
monument as found
and set Clm over
reset PI (capped 5/8" ϕ iron)
8.0' N. 5/8" ϕ iron found
over conc. mon. was
0.2' So. & 0.6' East of
conc. mon.

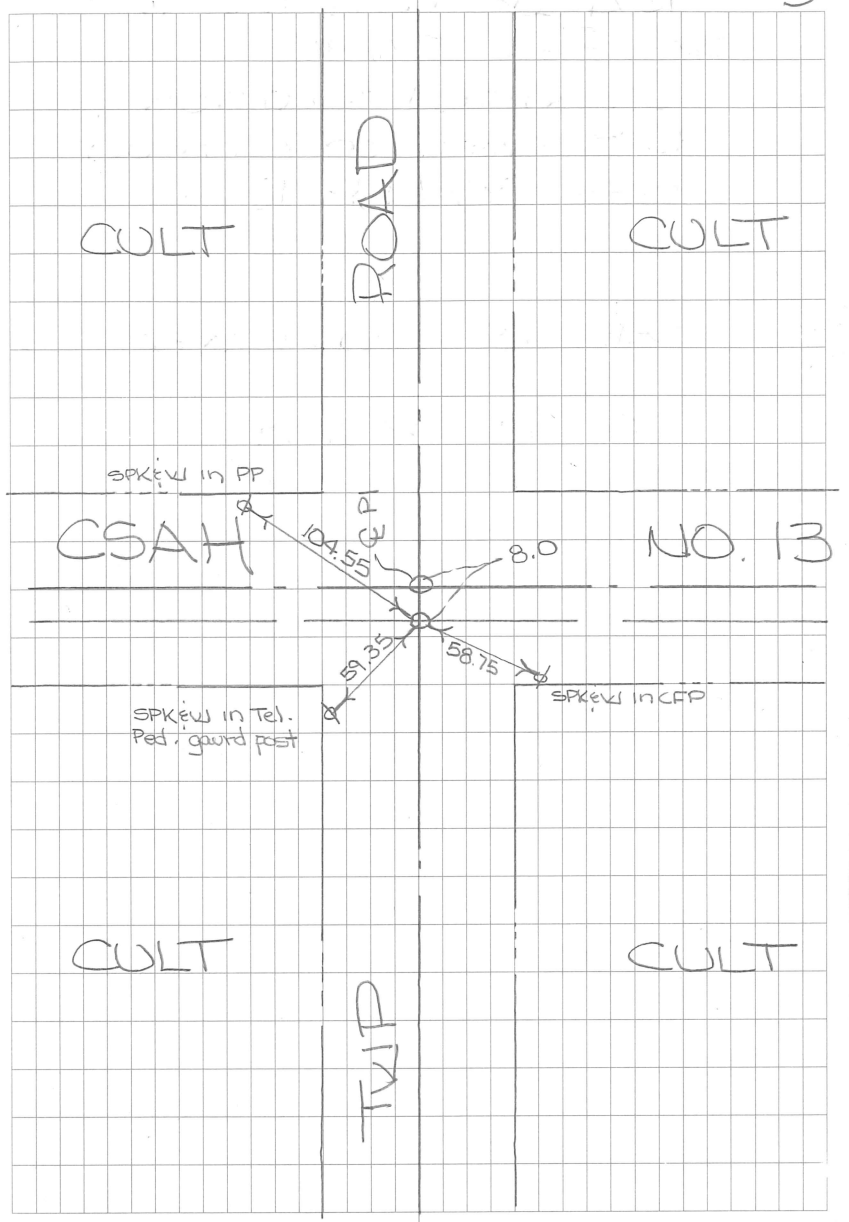

10-10-02 VHJ

SE COR SEC 34

10-10-02

FOUND SE COR & TP1
SEE BK 208 P40

