
NW Corner Sec 3-102-16
Cert. Filed 5-16-91 by JHS
Uncovered 2½ Brass
disk in pipe on
CL N-S-E-W roads
Set by C.D. Hosfield
in 1969 left mon.
as found 0.5' deep

5-10-91 DRR/RMK

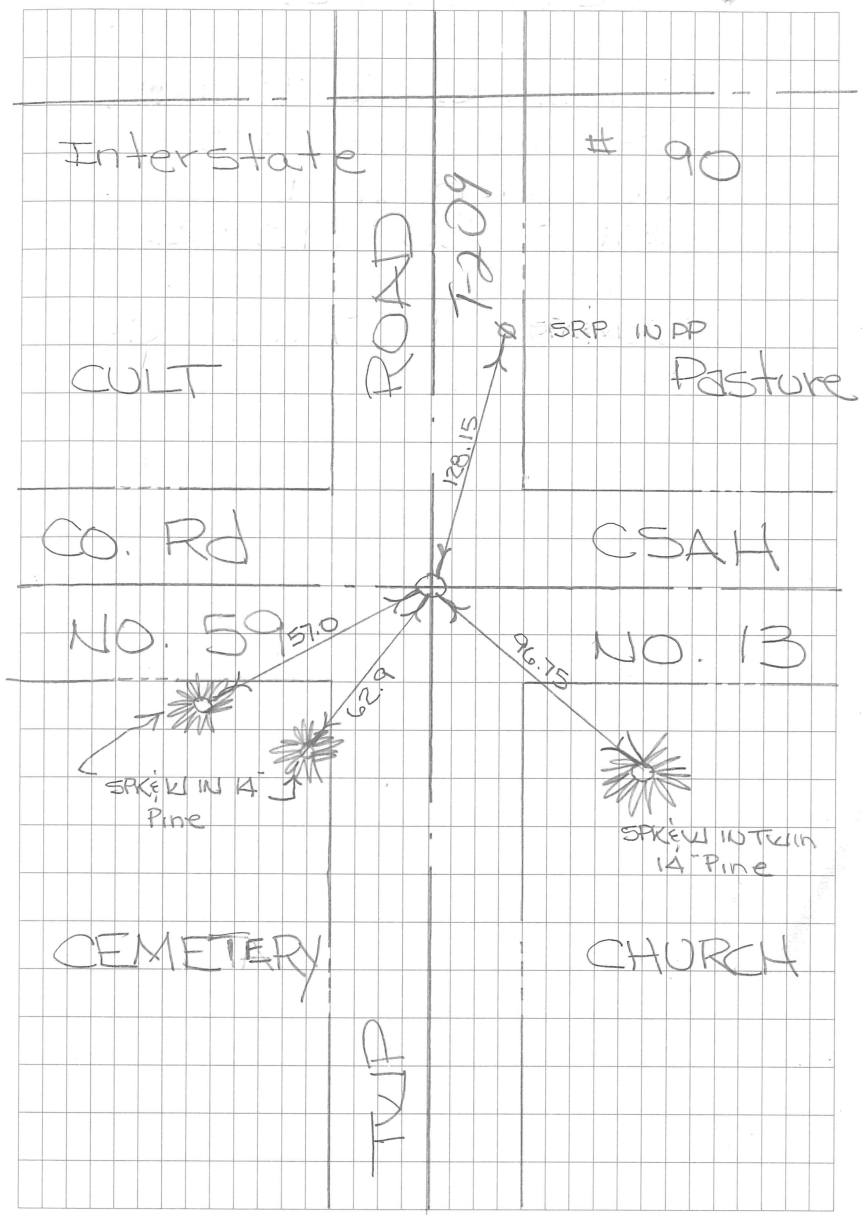

SW COR SEC 34

10-10-02

F 2" BRASS CAPPED PIPE
SET BY CHUCK HOSFIELD

SEE BK 208 P # 40

10-10-02 JAJ

51

