E 1/4 Cor Sec 6-102-16

Cert. Filed 12-16-92 by JHS

Dug with Co backhoe on ℄ N-S road in line with fe east dug a 6'x 15'x 3' deep hole and foond nothing.

SET CIM


"Note" SEE pg. 14 FOR FLD work.

9-14-00 TIED CORNER OFF. HLS CPU.

10-23-03 RESET CORNER. HLS TLM

SET SURVEY MARKER @ Rd. SURFACE.

9-17-92 DRR TJF ✓10

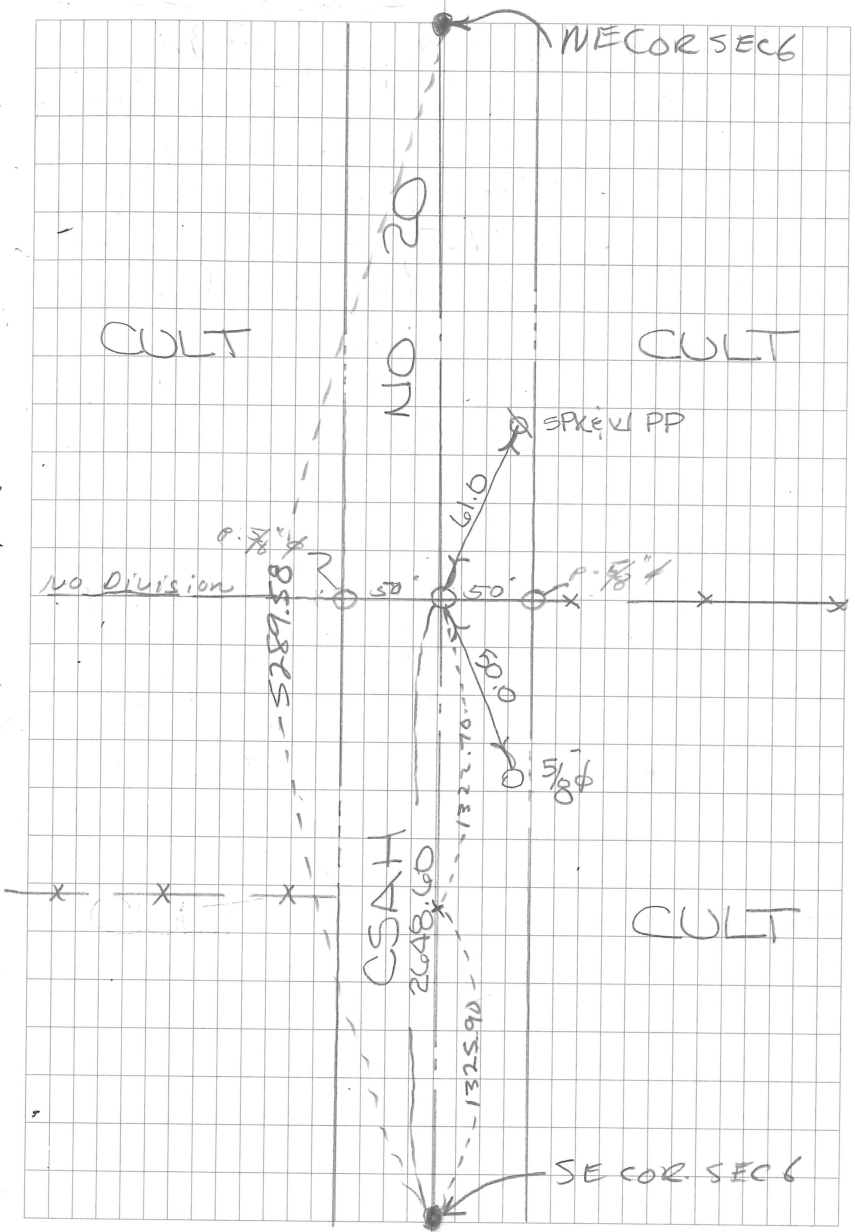

Set E1/4 Cor
Sec 6-102-16

T @ 1/16 line fe
BK ST SE Cor
D 1325.90

Tr. PT ∡ 181°04'18" 17"
D 3963.63

assumed 1/4 Cor
∡ 180°00'
D 1322.70

NE Cor ∡ 89°31'11" 10"
D 72.30

