
NE Cor SEC. 13-102-16
Cert. Filed 7-09-01

1920 Mower Co. Records State
INP MAg, Mon
60.1 NE To Top END of Apron
59.7 NW to Top END of Apron

JHS Crew Day by Hand
And Uncovered CastIron
Mon.

6-19-01
Cloudy
25°
HLS
SMT

63

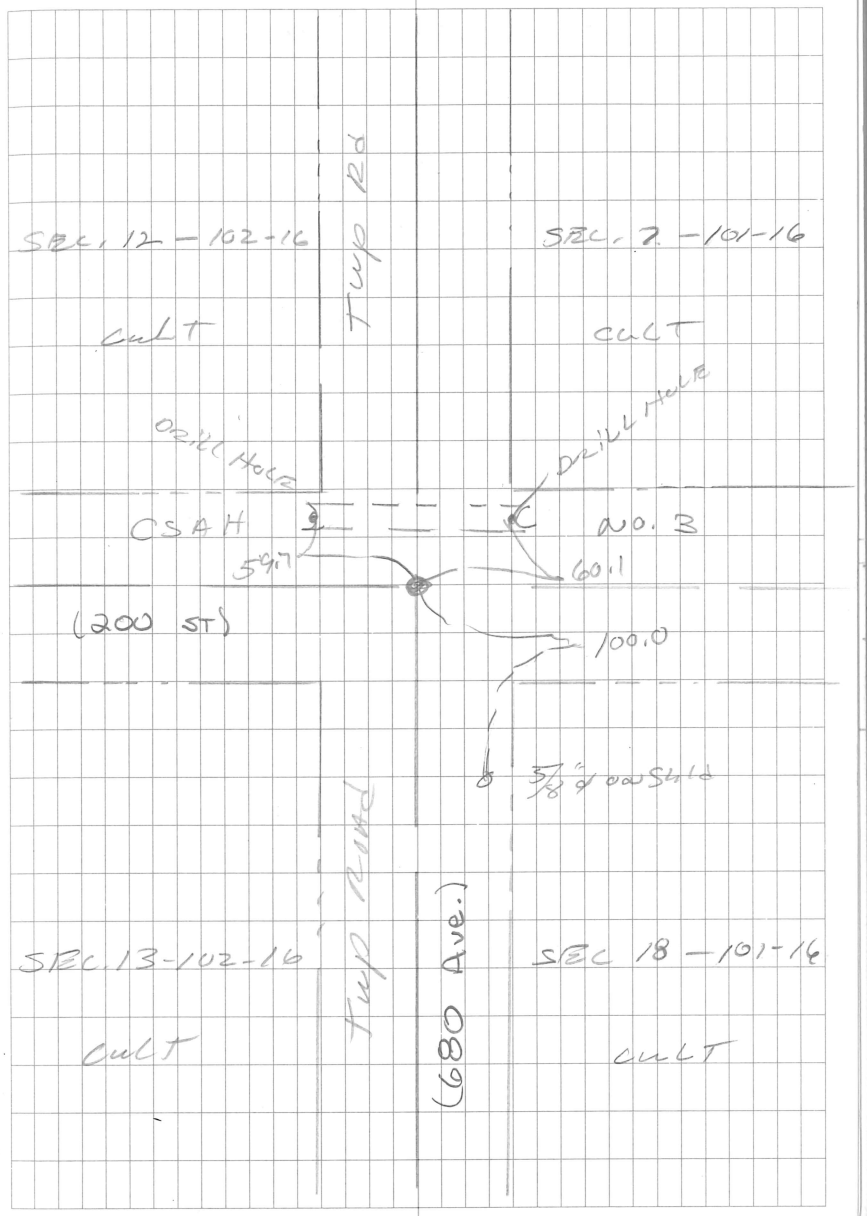

5-07-02 cloudy 60° HLS CPD

23

SW cor SEC. 7-102-15

SEE TIE BOOK

MARSHALL twp.

NE cor SEC. 13-102-16

