7-15-05 HLS
CLEAN MHS

S¼ COR SEC 13-102-16

NO INFORMATION FOUND IN MOWER CO. CORNER RECORDS

JHS CREW DUG WITH BOE BROS. BACKHOE, AT LOCATION OF 5/8" IRON, 5/8"ø FITS & E-W TWP RD. AND IN LINE WITH FIELD DIVISION NORTH.


10.5
17.7

UNCOVERED LARGE ROCK 2.3' WEST OF 5/8" IRON FOUND.

ACCEPTED ROCK AS TRUE CORNER.

SET 5/8" X 16" IRON WITH CAST IRON MON. OVER.

LARGE STONE FOUND .60± BELOW ROAD SURFACE

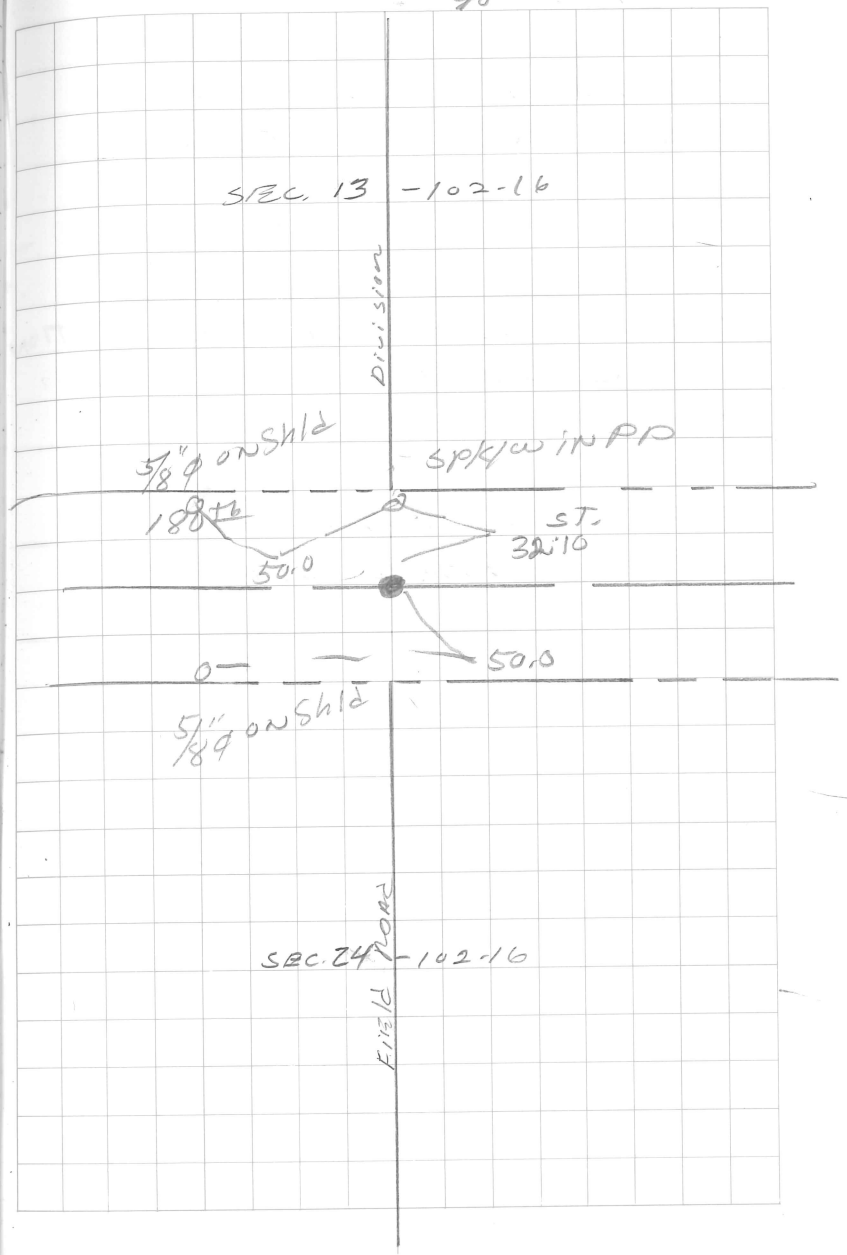

6-25-01
Cloudy
90°
HKS
SAT

Stakes SEC. 13-102-16

No Information Found
in Mower Co. Records.

SET TEMP 5/8" ø Iron on
℄ E-W Road, in line
with Line Ft. North.

