8-15-96
Cloudy
80°


HLS
JPA

N¼ COR SEC. 30-102-16

No Information Found in
Mower Co. Records
*See Page 45

To NW① cor
B/St W¼③ cor
D 2649.43
FS TRAV. PT②
∠ 00°00'00"
D 60.0
FS 1/16th Line "Wood Corner Post"
∠ 270°29'12"
D 1254.62
FS NE④ cor
∠ 270°35'00"
D 5172.17
FS Point on N¼ S. Line
∠ 270° 35'00"
D 2551.00
FS ½" Iron Found ½"ϕ set by
∠ 270° 46'00"
D 2551.68

"NOTE" SEE NEXT PAGE FOR NOTES.

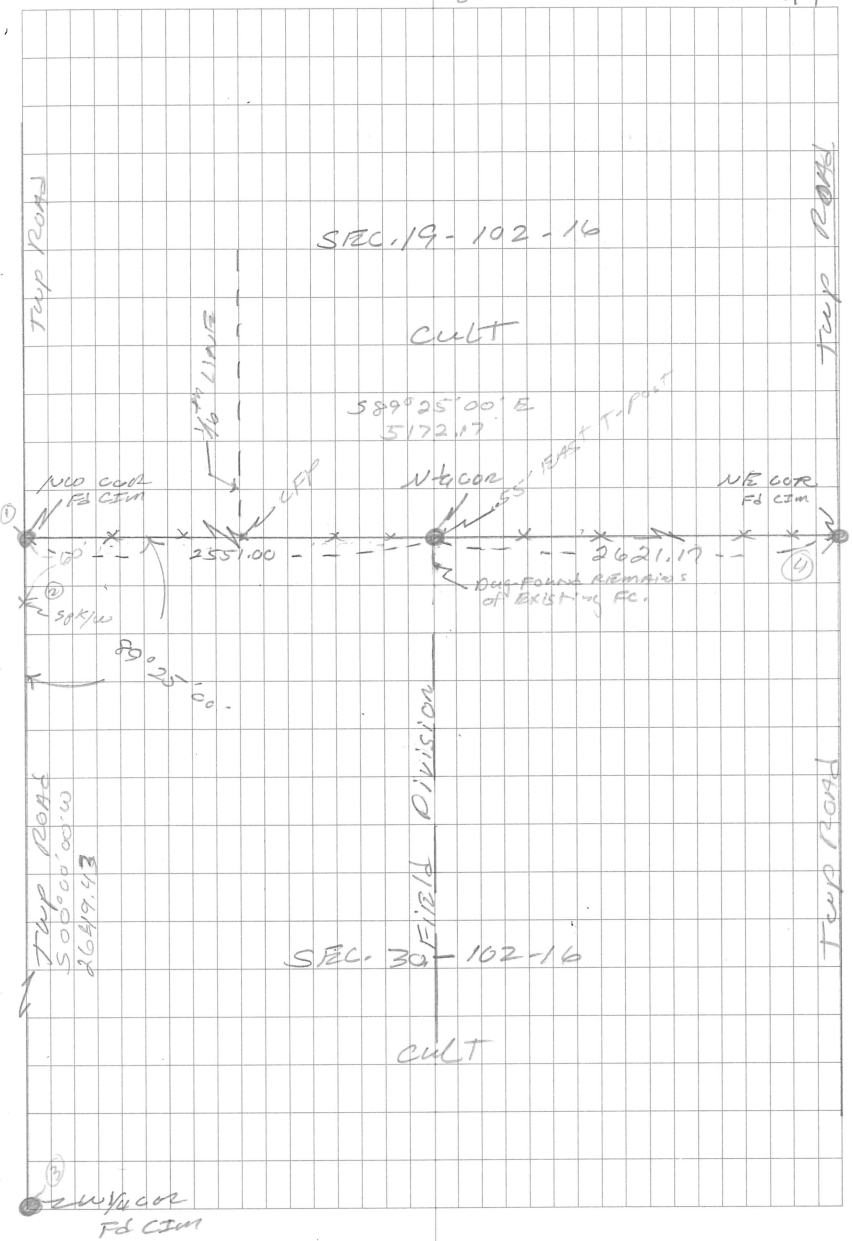

8-15-96
Cloudy
80°

HLS
JAP

45

N¼ cor SEC. 30-102-16
Cert. Filed by JHS 4-22-97

JHS CREW SET N¼ cor USEING
E-W FENCE, DUG AND UNCOVERED
EXISTING South FENCE.
SET cor ON Straight LINE
BETWEEN NW & NE CORNERS, AND
IN LINE with EXisting South FENCE
South CORNER Fits E/W LINE FENCE
AND South UNCOVERED FENCE - Field Division
SET ⅝" x 2' IRON with CASTIRON
MON. OVER IRON, At GROUND SURFACE,
CORNER .55 EAST of T-Post.

