
5-7-91 DRR/RMK 1 ✓
PC 45°

X 1¼ Cor Sec 27-102-17
Cert. Filed 5-9-91 by JHS
Dug with Co. backhoe on ℄ℓ of Rd for bituminous overlay project # CP 50-91-06-52

Dug a 5'x 10'x 3' deep hole and uncovered a Harrison Clm 2' below road surface removed Clm and 1' below found conc. mon. in 6" clay Tile with ½"ϕ iron cast in ctr. left conc. mon. as found and set Clm over it on road surface

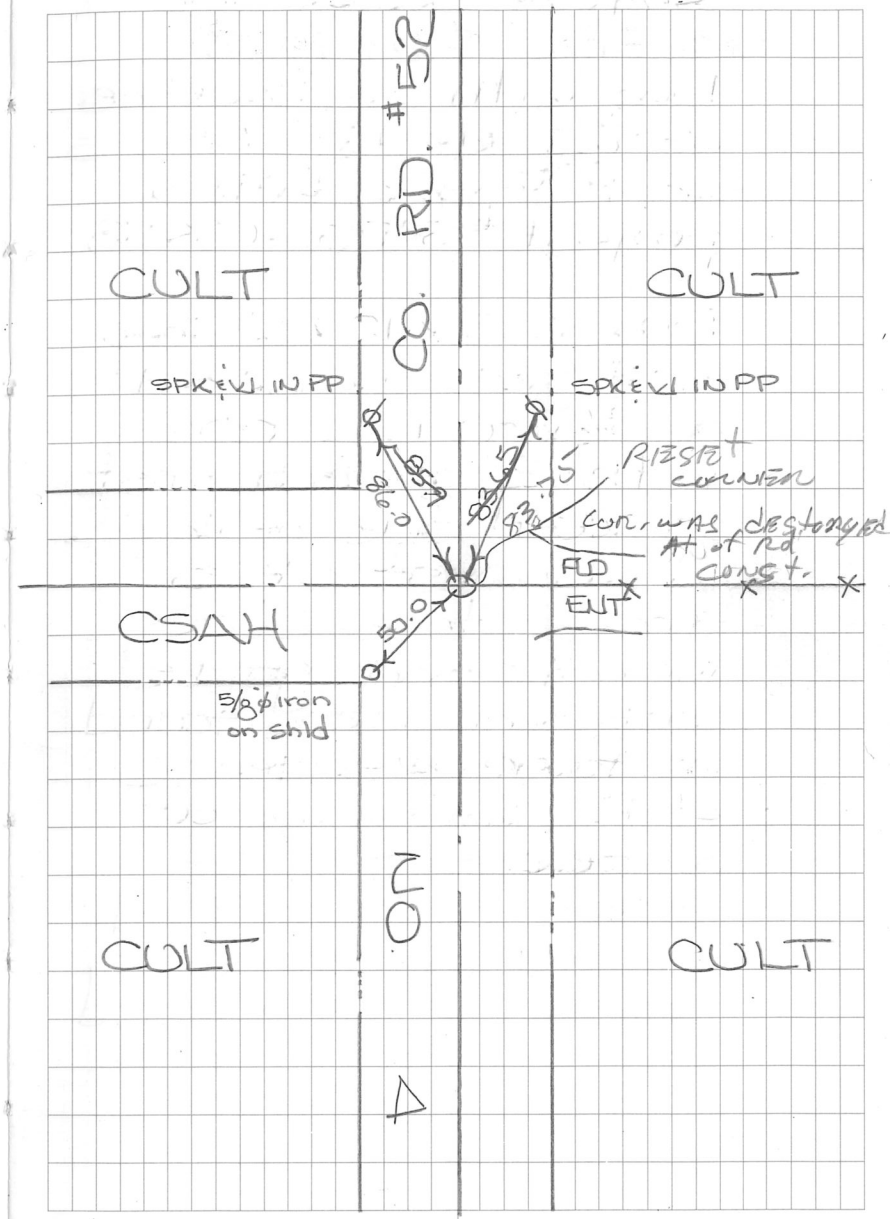

4-23-04 RESET CORNER WITH GPS.
SET 5/8"ϕ WITH CASTIRON MON. OVER. ON SOUTH EDGE of DRIVE.
CORNER WAS DESTORYED AT TIME of ROAD CONST.