1


E¼ cor SEC. 31-102-17

NO INFORMATION FOUND IN MOWER CO. CORNER RECORDS

THIS CREW DUG WITH MOWER CO. BACKHOE, ON C N-S TWP RD. AND IN LINE WITH FIELD DIVISION E & W

DUG AT A POINT BY DOUBLEING 1/16th LINE OVER FROM THE SOUTH. POINT FIT FIELD DIVISION E-W.

DUG A 6' X 12' HOLE DOWN TO VIRGIN SOIL AND FOUND NO EVIDENCE OF PLS CORNER.

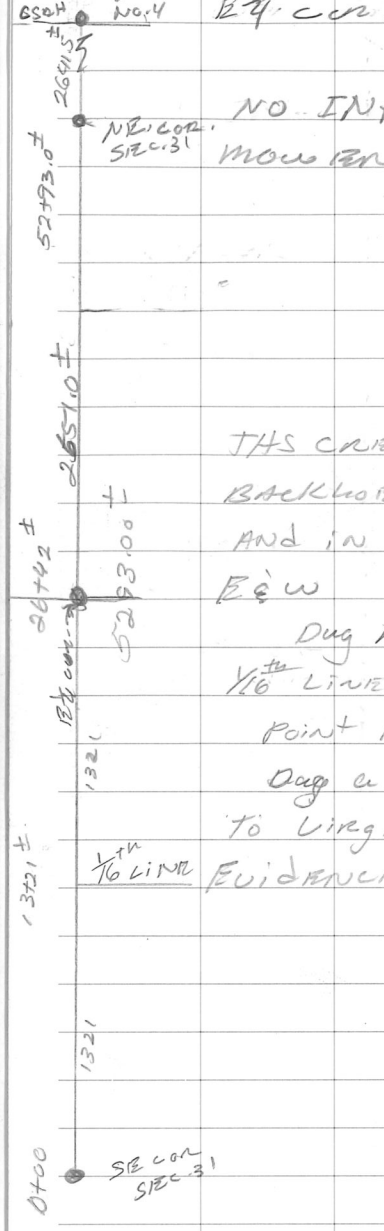

8-21-02
Cloudy
>50°
HLS
SAT

51

