
SE-COR SEC 16-102-18
cert. Filed 3-31-93 by JHS

FOUND 3/4"Ø x 24" IRON ON ℄ TH 105 IN LINE WITH FENCE WEST. Dug 1.5' DEEP AND FOUND NOTHING, PROBED AREA TO 4' DEEP and FOUND NO EVIDENCE OF STONE ON 1939 ROAD PLAN. SET CIM NEAR ROAD SURFACE IN SAME LOC. AS 3/4"Ø x 24" FOUND.

NOTE COR. WAS DUG WITH CO. BACKHOE ON AUG OF 1993. SEE Pg. 16 FOR INFO

3-24-93
CLOUDY 40°

DRR
FKS 13.

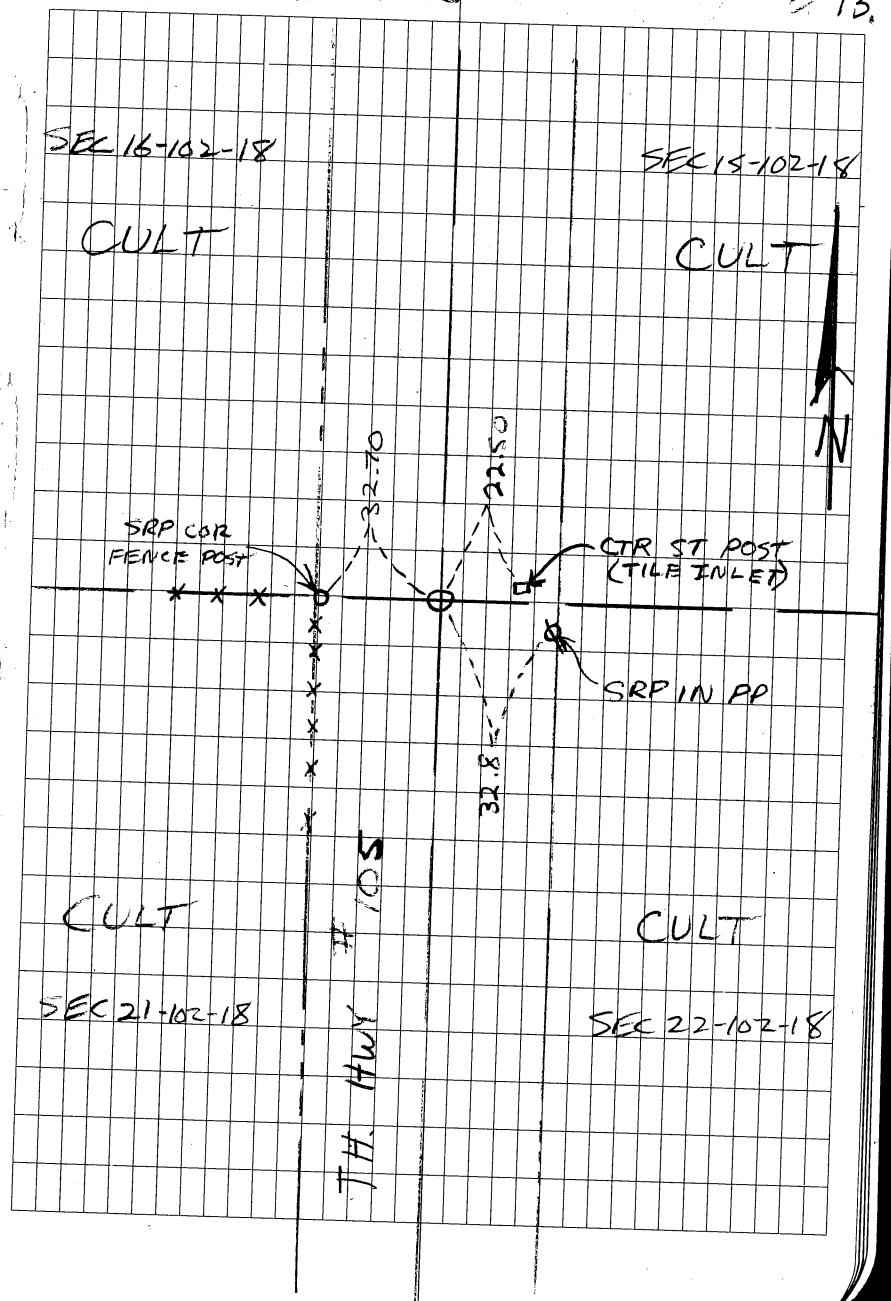

SE Cor Sec 16-102-18

Cert. Filed 3-31-93 by JHS

See Pg. 13 for ties

Dug with Co. backhoe on E-W road in line with fe. west and found CIM set by JHS crew in Jan. 1993 mon. was set at loc. of 3/4 ~~pipe~~ IRON, found CIM to be directly over large pointed triangular stone 3' deep reset CIM over stone.

NOTE SEE Pg 13 FOR TIES

8-24-93 DRR 16

