
E¼ cor SEC. 24-102-18

No Information Found in Mower Co. Corner Records

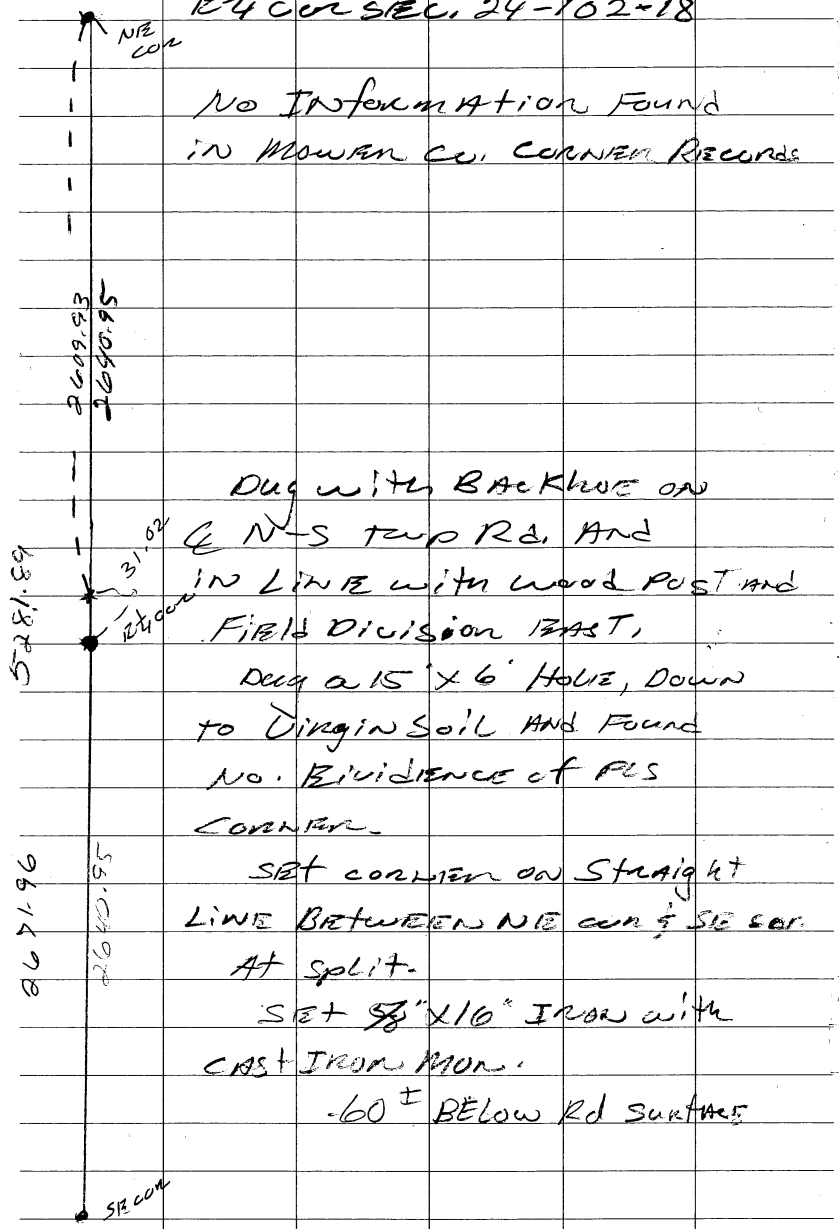

Dug with Backhoe on ℄ N-S Twp Rd. and in line with wood post and Field Division East, Dug a 15' x 6' Hole, Down to Virgin Soil and Found No. Evidence of PLS Corner.

Set corner on Straight Line Between NE cor & SE cor. At split.

Set ⅝" x 16" Iron with Cast Iron Mon.

-60± Below Rd Surface

7-21-93 Cloudy 75°

HLS Trim

43

