
NE Cor Sec 1 - 103 - 14
Cert. Filed 4-3-91 by JHS
Found 1/2 dia. iron cast in the center 5' dia. conc. mon. on ℄ N-S road in line with fence east


8-16-06 AKP ESL FOUND 1/2" ø ; SHOT W/GPS.

3-11-91 DRR/JHLS 1.

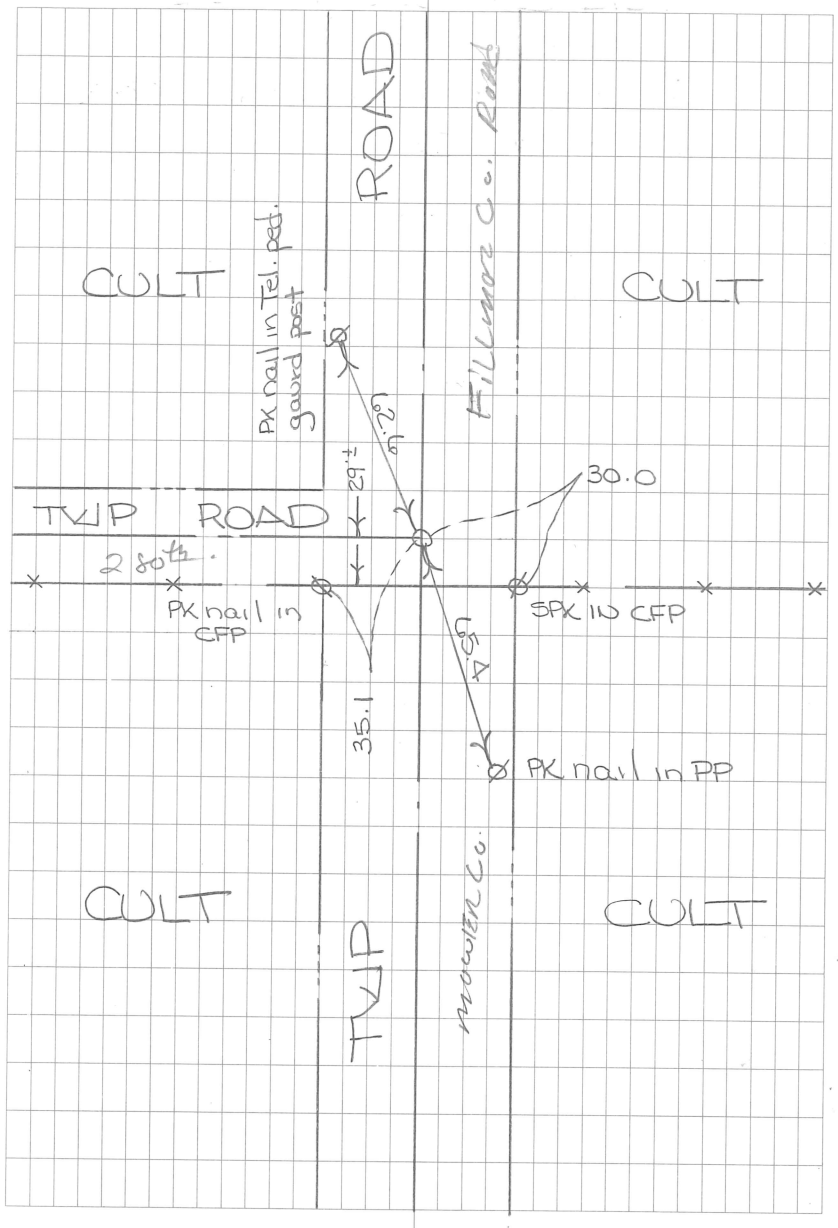

NE Cor Sec 1-103-14

Found ½" ϕ iron in conc. 1.0' below road surface in line with fence east, left mon. as found

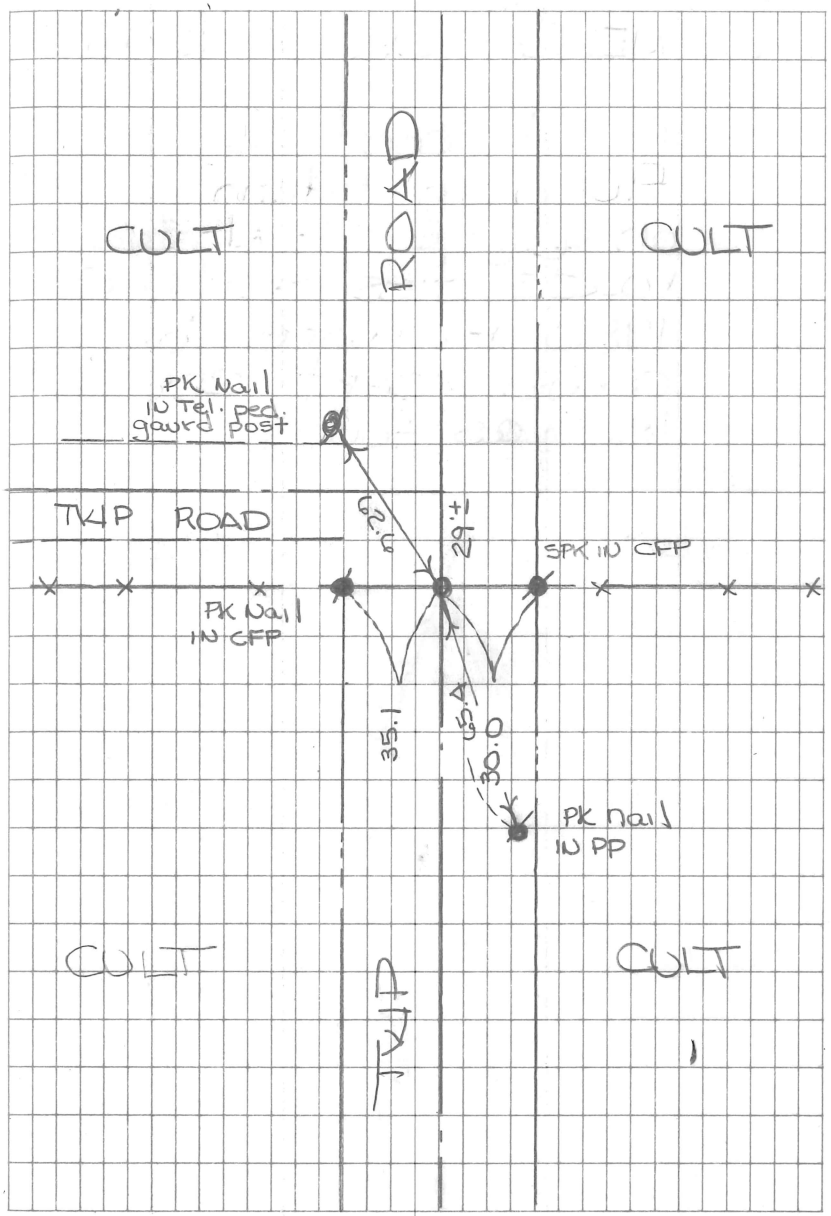

NE Cor Sec 1-103-14
(FRANKFORD TWP)
Cert. Filed by JHS 4-3-91
Found ½" ϕ iron cast in center of 5" dia. conc. monument 1' below road surface. left monument as found

3-11-91 DRR/HLS 1/

