
E 1/4 COR SEC 3

2004
JHS CREW FOUND NO EVIDENCE OF ORIG PLS MON. TRAVERSED AROUND SEC 4 TIED IN EXISTING SEC 4 1/4 SEC 4 FENCE LINES.

COMPUTED POSITION OF E 1/4 COR TO BE 165' NORTH OF CFP D SE COR N SACRES OR E 1/2 SE 1/4. THIS LOCATION FITS EXISTING OCC'S WITHIN SECTION 4 THE RULE OF PARALLELISM

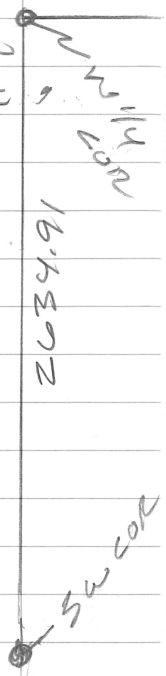

8-2-04 HLS

