5-4-94 HLS

34


N¼ cor SEC 6-103-14

1853 JOHN BALL, deputy surveyor, set a post at the corner and found:
N 87° 30'W 935 LINKS to 10" BLACKOAK
N 83° E. 913 LINKS to 10" BURR OAK.

MAY 2-94 STEVEN J. THOMPSON, LS 22705 EXCAVATED @ 5.5' DEEP TRENCH using BACKHOE & EXTENDING 4' NORTH AND 4' SOUTH by 6' WEST AND 5' EAST of CENTERLINE INTERSECTIONS. A 0.6' DIAMETER by 1.0' high STONE WAS FOUND with POINT up. 3.5' BELOW THE SURFACE.

AN ANALYSIS of THE RECORD GIVES NO INDICATION of THE ORIGIN of THE STONE. STONE of SIMILAR SIZE AND SHAPE HAVE BEEN FOUND AT OTHER CORNERS THROUGHOUT THIS Co. THIS STONE IS ACCEPTED AS MARKING THE LOCATION of THE ORIGINAL public land SURVEY CORNER.
SET MONUMENT Co. MON - CORNER CERT.


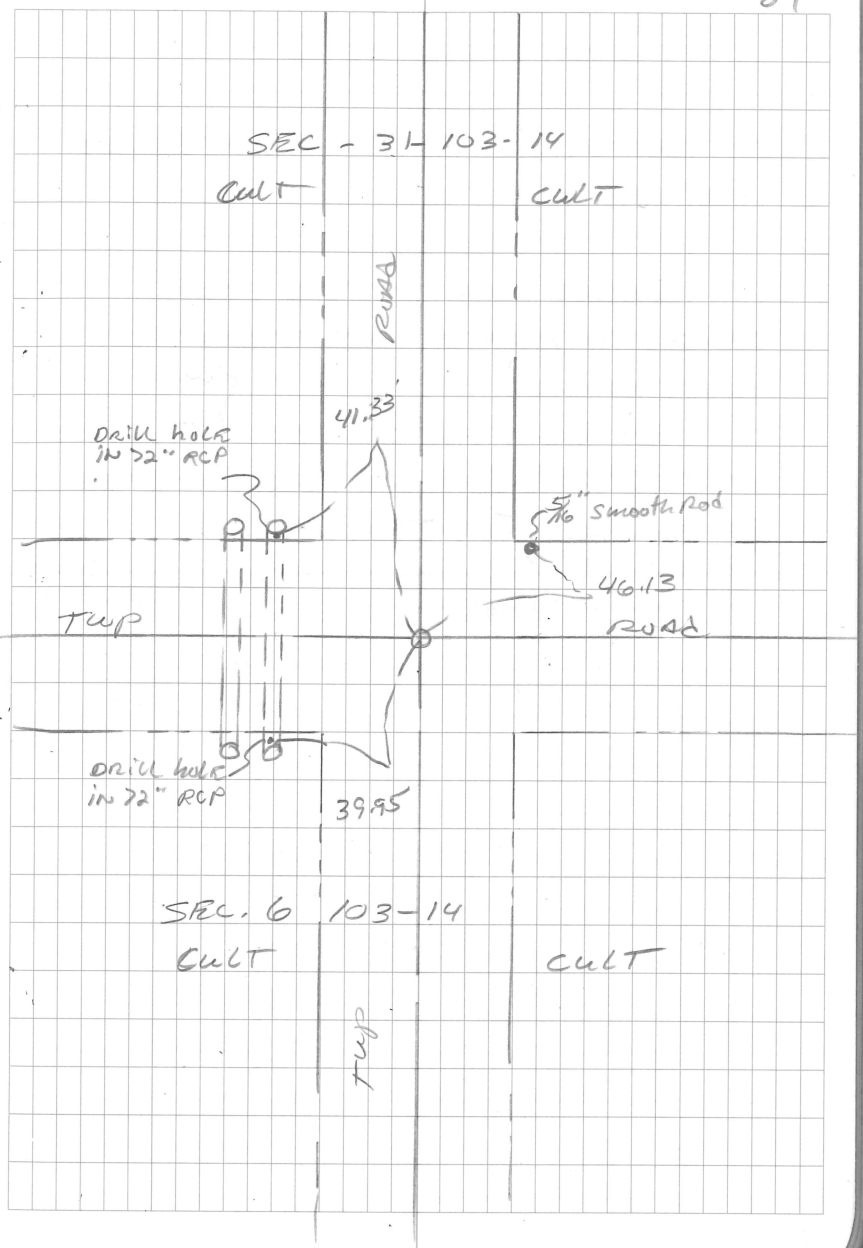

8-15-06
SUNNY 70°

AKP
EXL 35

S 1/4 COR SEC 31-104-14

JHS DUG @ LOCATION OF OIP & FOUND ALUM MON 1.4' BELOW ROAD SURFACE WHICH FIT & N-S : & E-W ROADS, TIED OFF. SHOT W/GPS.

