
NE COR SEC. 6 - 103 - 14

1853 JOHN BELL deputy surveyor, SET a post at corner & found N. 87° 30' E 16.43 Links to 6" BURR OAK N 80° W. 4.85 Links to 14" BURR OAK S 50° E. 4.80 Links to 14" BURR OAK

MAY 2-94 STEVEN J. THOMPSON LS 22705 EXCAVATED a 4' foot deep TRENCH using a BACKHOE AND EXTENDING 4' NORTH & 4' by 2' FEET EAST of the N-S FENCE LINE, A 0.8' DIAMETER by 1.3' FEET high STONE was found with the POINT UP, 2.0' BELOW the SURFACE AN ANALYSIS of RECORDS give NO INDICATION of the ORIGIN of the STONE. STONES of SIMILAR SIZE & SHAPE WERE BEING FOUND @ other CORNERS throughout the COUNTY. The STONE is ACCEPTED AS MARKING the LOCATION of the ORIGINAL public LAND SURVEY CORNER, SET @ MARKED DEPTH. CORNER IS CERTIFIED. (COPIED from THERE)

5-4-94 HLS

33

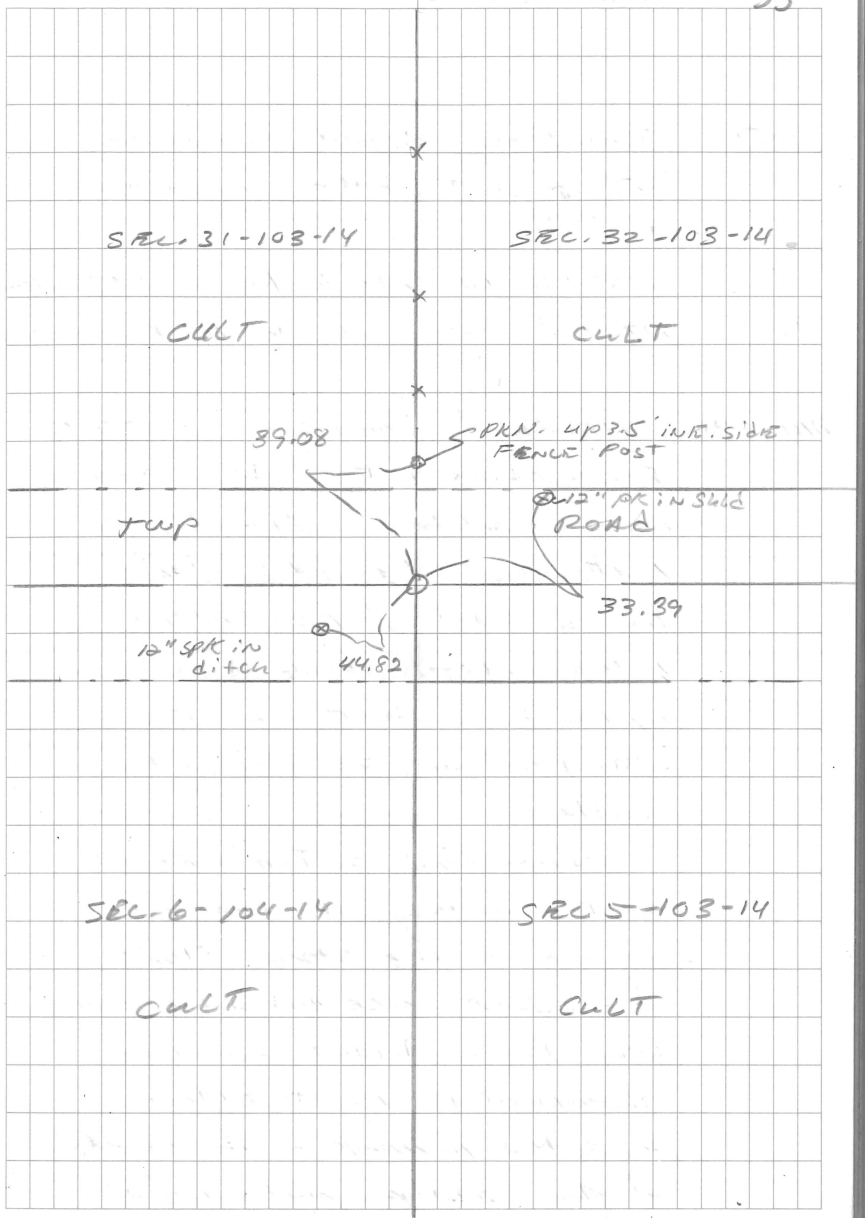

8-15-06
SUNNY 70°

AKP
ENL

SE 1/4 COR SEC 31-104-14

JHS CREW DUG @ LOCATION OF DIP ;
FOUND ALUM MON 0.6' BELOW ROAD
SURFACE ; ±2' SOUTH OF ℄ OF 280 ST.
FITS FENCE LINE NORTH. TIED OFF. SHOT W/GPS.

