
W¼ cor SEC. 8-103-14

MOWER CO. RECORDS STATE
INP. STONE
CSAH #2 ROAD PLAN shows
CORNER to BE 2' SO OF ℄

JHS CREW Dug with with
MOWER CO. BACKHOE. At LOCATIONS
of 1"X4" pipe. Dug a 3'x6'
HOLE 6'± DEEP AND FOUND
NO EVIDENCE of PLS CORNER
OR STONE AS MOWER CO. RECORDS
STATED.


SET COR using CO. RD. PLAN
At @ DIST. of 5430.42 From W¼ cor
SEC 7-103-14

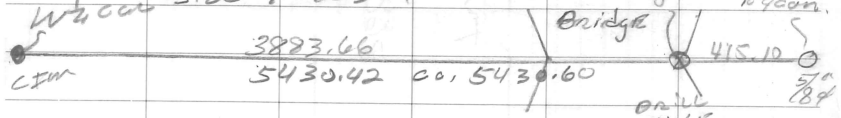

FOUND CO. TIE. ¾"ϕ SSCW 25.0
FD 75.10 to COR.
SET 5/8"X16 IRON CAP. 13807

SEE pg 63

10-10-02
CLOUDY
60°
HLS
EPB
TLM
61

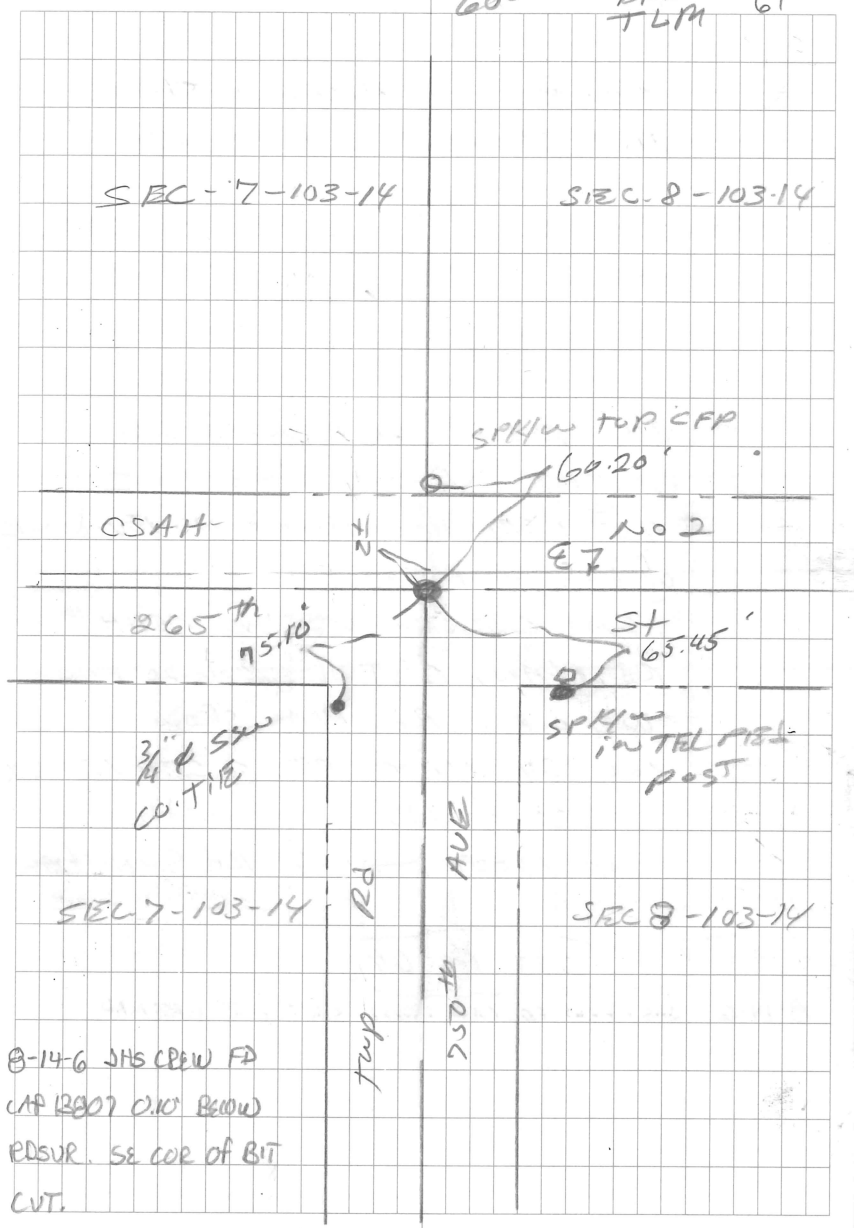

W¼ cor SEC. 8-103-14

E¼ cor SEC. 8-103-14

SIZE Co. Rd. PLAN.

To POC

BS W¼ cor. SEC 7

D 1131.76

FS PI @ STA 50+15.5

Δ 3883.66

FS W¼ cor @ STA. 54+30.06

Δ 180°00'00' 4298.76

/ W

To PI. @ STA. 80+64.0

BS W¼ cor. @ STA. 54+30.6

R 2633.40

FS E¼ cor @ 107+06.8

D 180°00'00' 2642.80

/ W

P cone NAIL

PK CIM

DRILL HOLE

P 7/8"

P cone NAIL

10-16-02
CLOUDY

HLS
ERB

63

