E½ SEC. 8-103-14

MOWER CO. RECORDS STATE
INP STONE TO WEST STAKE

JHS CREW DOUG MOWER CO.
BACKHOE. DUG A 4'x8' HOLE
4.0± DEEP AND FOUND NO EVIDENCE
OF PLS CORNER.
SET CORNER USEING CSAH #2
RD. PLANS DIST OF S2°16.20 FROM
W¼ COR. RD. PLAN SHOW
COR. 24' N. OF PI. @ STA 102+06.8
SET ⅝" x 16" IRON WITH
CAP: 13807 — @ RD SURFACE


SEE Pg 64

8-14-G JHS CREW FD CAP 13807 SHOT FOR BASEMAP

10-16-02
Cloudy
50°

HLS
EPIB

62

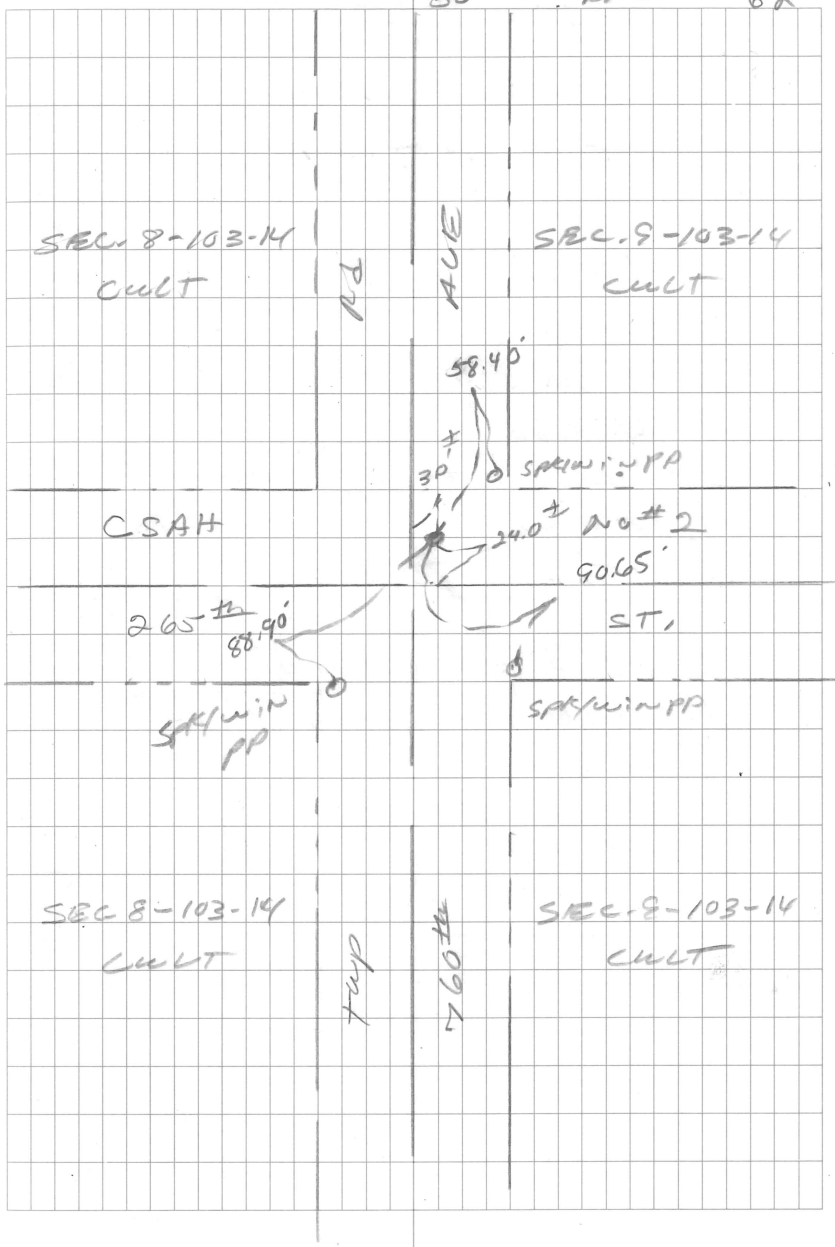

W¼ cor SEC. 8-103-14

E¼ cor SEC. 8-103-14

SIZE Co. Rd. PLAN.

To POC

BS W¼ cor. SEC 7

D 1131.76

FS PI @ STA 50+15.5

Δ 3883.66

FS W¼ cor @ STA. 54+30.06

Δ 180°00'00' 4298.76

/ W

To PI. @ STA. 80+64.0

BS W¼ cor. @ STA. 54+30.6

R 2633.40

FS E¼ cor @ 107+06.8

D 180°00'00' 2642.80

/ W

P cone NAIL

PK CIM

DRILL HOLE

P 7/8"

P cone NAIL

10-16-02
CLOUDY

HLS
ERB

63

